

UNITED STATES PUBLIC LAND SURVEY CORNER CERTIFICATE


Land Survey Monuments situated in Section 22, Township 88N, Range 12W, of the Fifth Principal Meridian, BLACK HAWK County, Iowa.
Previously recorded in N/A in County Recorder's Office.
(book, page, document number, etc.)

(Show reason for preparing this certificate, the evidence and detailed procedures used in establishing the corner positions and monumentation found or placed.)

Monument Description and Remarks E 1/4 COR. FOUND 5/8" Ø REBAR 4" DEEP IN ASPHALT
PER CES TIES. 1966, & SCHMITZ'S 2ND ADD. PLAT. (CONS. MON. 1966)

PLAN - VIEW

(Show a minimum of three reference ties to durable physical objects, relevant monuments and physical conditions that will enable recovery of the corner.)

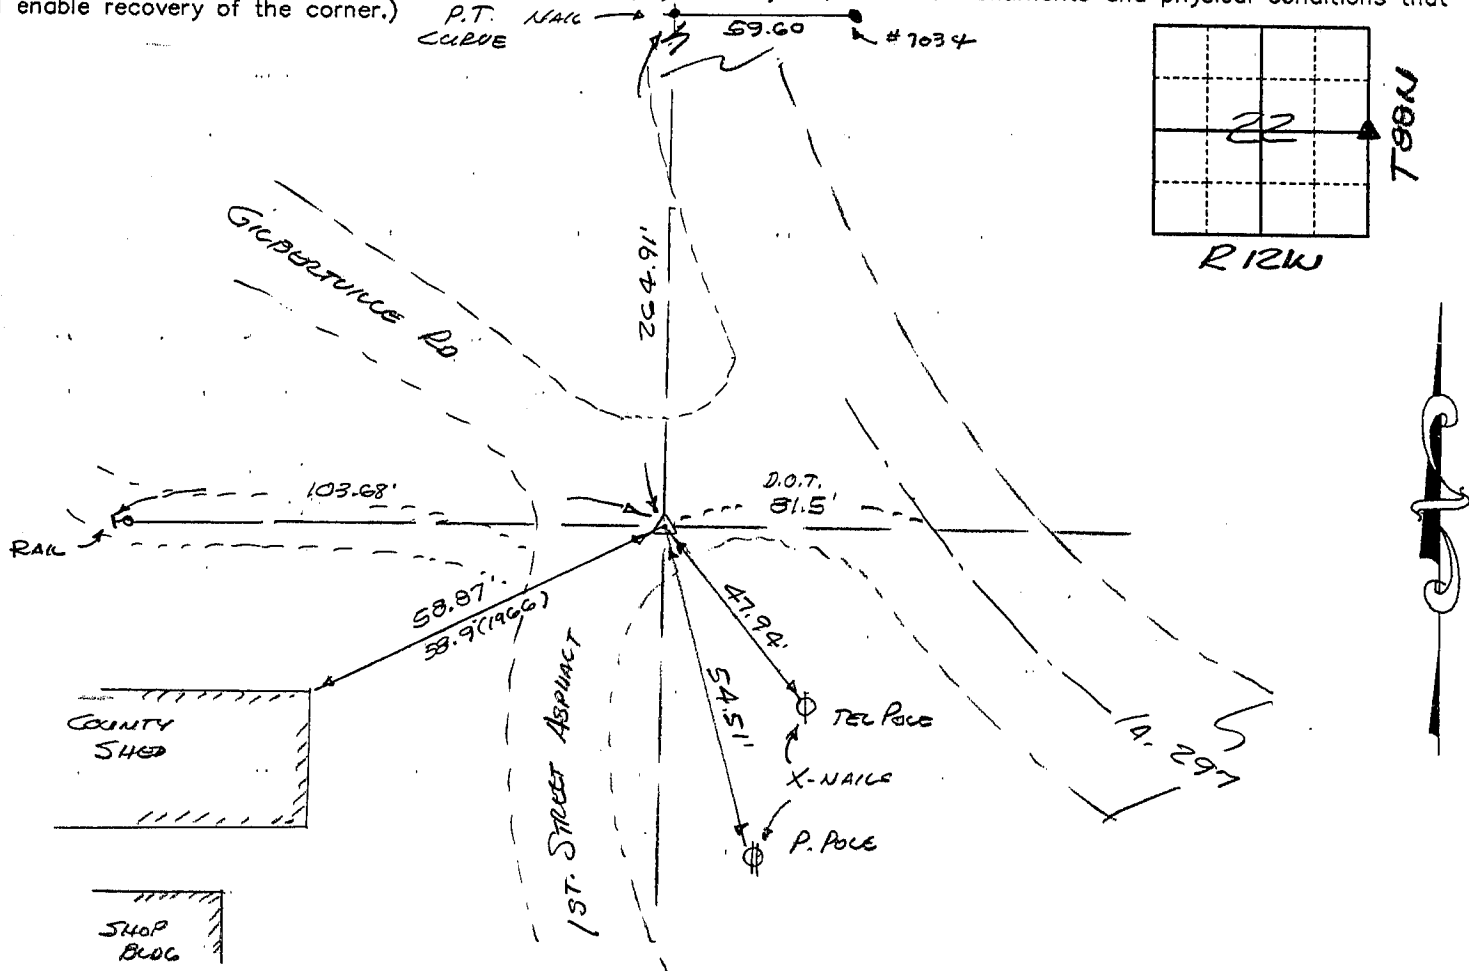


410-50

I hereby certify that the survey work was completed and this certificate was prepared by me or under my direct personal supervision and that I am a duly registered land surveyor under the laws of the state of Iowa.

Signature: F. William King
(Name typed or printed: F. WILLIAM KING)
Date: 12-20-95 Reg. No. 8033

SEAL

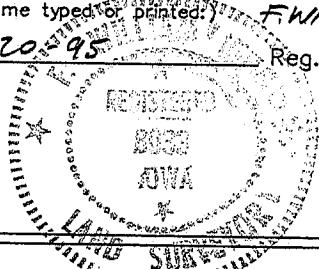

List Corners to be Indexed

Corners	Section	Twp	Range
<u>E 1/4</u>	<u>22</u>	<u>88N</u>	<u>12W</u>

MISC. BK. 319 p. 7