


# UNITED STATES PUBLIC LAND SURVEY CORNER CERTIFICATE

RECORDED

CORNER IDENTITY:  $\frac{1}{4}$  Corner Section 23-88-12

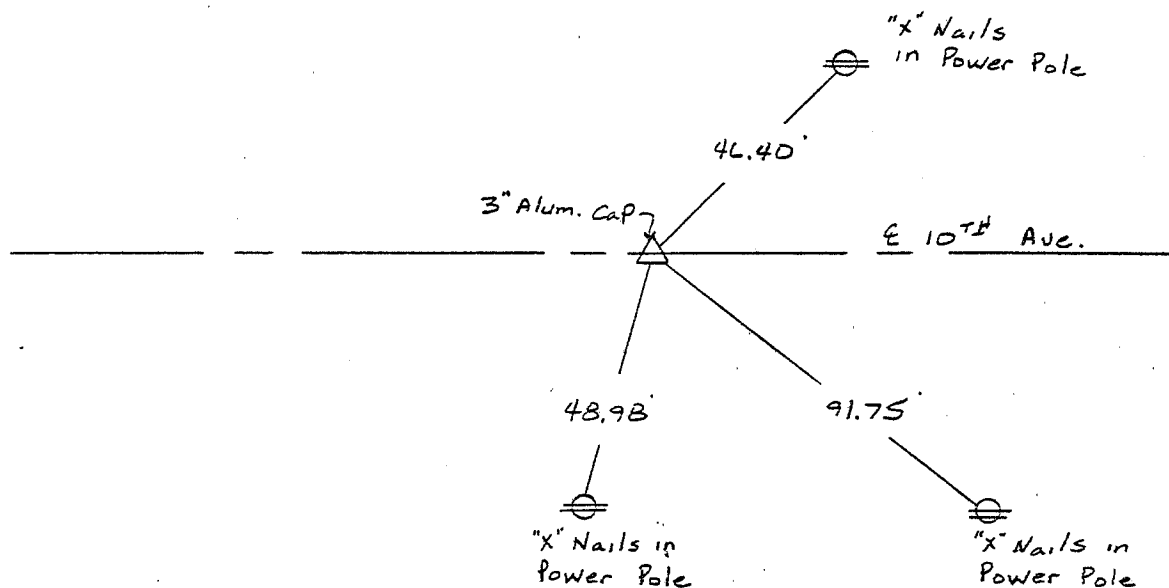

## REFERENCE TIES

DATE SURVEYED: 12-17-92

DATE DRAWN: 1-6-93

REASON FOR PREPARING CERTIFICATE: No certificate on file.

### PROCEDURE USED AND

CORNER DESCRIPTION: Found 3" aluminum cap at top of asphalt road.

### CERTIFICATE

I hereby certify that this plat, map, survey or report was made by me or under my direct personal supervision and that I am a duly Registered Land Surveyor under the laws of the State of Iowa.

My registration expires December 31, 1994.

1/11/93  
Date

*F. R. Debe*  
F. R. Debe

