

PREPARED BY: BLACK HAWK COUNTY ENGINEERS OFFICE
316 E. FIFTH STREET, ROOM 211 WATERLOO, IOWA 50703PH.# (319) 833-3008
FAX.# (319) 833-3139SLSI 9-94
CERT 12-96

UNITED STATES PUBLIC LAND SURVEY CORNER CERTIFICATE OF
Land Survey Monuments situated in Section 26, Township 88 N,
Range 12 W, of the Fifth Principal Meridian, BLACK HAWK County, Iowa.
Previously recorded in Misc. Book N/A, Page N/A, in County Recorder's Office.

(Show reason for preparing this certificate, the evidence and detailed procedures used in establishing the corner positions and monumentation found or placed.)


Monument Description and Remarks: E. 1/16th COR., NORTH
FOUND STEEL SPIKE IN ACC PVM'T MARKED "SURVEY MARKER" @ ± PHYS. C.L. OF POYNER RD. (D38). NO CURRENT CERT. OF RECORD. CORNER REFERENCE PART OF SECTIONLINE & R/W SURVEY FOR GILBERTVILLE ROAD RECONSTRUCTION PROJECT, S.E. OF TOWN OF GILBERTVILLE. RESEARCH OF AREA PLATS NOTES CORNER REF. PER FEE BK. 2009-003310. PHONE CONV. ON 12/03/08 w/PLS #9961 STATED CORNER WAS "SET" AS PART OF SAID PLAT, AT THEOR. SPLIT OF N. LINE, N.E.1/4. DIFFERENCE OFF SAID LINE NOTED @ 0.29' NORTH. CORNER FURTHER NOT REF. TO RECORD PLAT SOUTH ALONG "EAST LINE OF SW1/4-NE1/4 OF SAID SECTION", PER MISC. BK. 287p.102 AS STUBED IN FROM OCCUPATION LINE (CORNER POST) OF RECORD. FND. CORNER TIED AND FILED FOR PUBLIC RECORD.

NOTE: ALL DISTANCES PLUMB/HORIZ.
(H.D.), "UNLESS DENOTED".


PLAN VIEW

BHco Hist. Ties: N/AFIELD BOOK: BHco. #488 p.31

(Show a minimum of three reference ties to durable physical objects, relevant monuments and physical conditions that will enable recovery of the corner.)

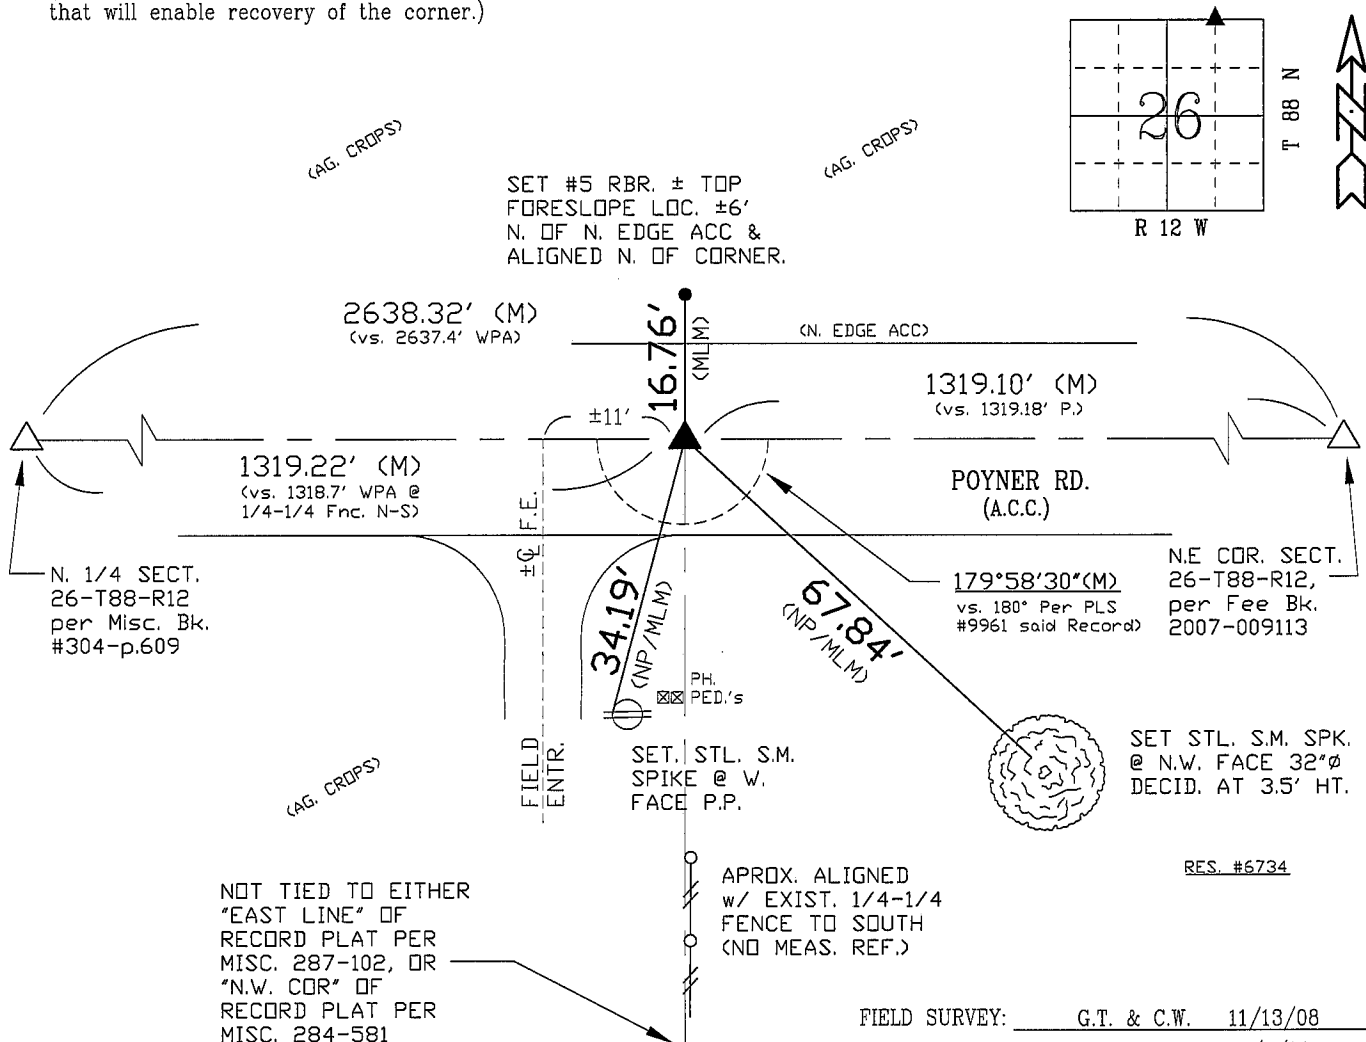

CERTIFICATION

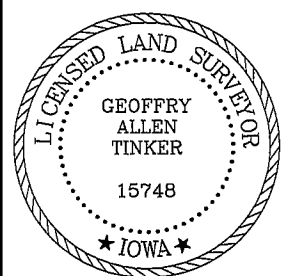

I hereby certify that this land surveying document was prepared and the related survey work was performed by me or under my direct personal supervision and that I am a duly licensed Land Surveyor under the laws of the State of Iowa.

Geoffrey Allen Tinker 12/03/08
Geoffrey Allen Tinker (date)

License Number 15748My license renewal date is December 31, 2008

Pages or sheets covered by this seal:

This Land Corner Certificate Only.

LIST CORNERS TO BE INDEXED

Corner	Section -	Township -	Range
N.E. Cor.	26	88 N	12 W
NW1/4-NE1/4			
S.E. Cor.	23	88 N	12 W
SW1/4-SE1/4			

INDEX OF ABBREVIATIONS

(M) = "Measured" Dimension
(P) = "Platted" Dimension
(R) = "Record" Dimension
(C) = "Calculated" Dimension
"IGS" = Iowa Geodetic Survey
"WPA" = Works Progress Admin. Survey
"G" = per George Miller Survey (BHco Surveyor 1858-1880)
"B" = per John Ball Survey (BHco Surveyor 1866-1891)
"N" = per Nathan Barber Survey (BHco Surveyor 1908-1931)
"NP" = Reflectorless EDM Meas.
"MLM" = Indirect Measure
"CM" = Concrete Monument
"SM" = Survey Marker Spike/Tag