

Doc ID: 004298370001 Type: GEN Kind: CORNER Recorded: 10/29/2010 at 03:29:11 PM Fee Amt: \$0.00 Page 1 of 1 Black Hawk County Iowa JUDITH A MCCARTHY RECORDER

File 2011-00008585

PREPARED BY:


BLACK HAWK COUNTY ENGINEERS OFFICE 316 E. FIFTH STREET, ROOM 211

WATERLOO, IOWA 50703

PH.# (319) 833-3008 FAX.# (319) 833-3139

UNITED STATES PUBLIC LAND SURVEY CORNER CERTIFICATE OF Land Survey Monuments situated in Section_ _, Township<u>88 N</u> <u>28 </u> Range 12 W , of the Fifth Principal Meridian, BLACK HAWK County, Iowa. Previously recorded in Fee Book 2005, Page 21078, in County Recorder's Office. (Show reason for preparing this certificate): The corner monument has been Replaced or Modified, per Ia. Code 355.11(1)(c) (Evidence and detailed procedures used in establishing the corner position(s) and monumentation found or placed.) Monument Description and Remarks: N.E. COR.: FND. 5/8" REBAR @ 2" DEEP IN EXIST. A.C.C. ROAD SURFACE. IN ADDITION TO CURRENT CORNER RECORD, CORNER REF. BY B.H. CO. ENG. PER BK. 473 p.4 OF CO. ENG. RECORDS (DTD. 10/01/1996), THAT UTIL. CORNER

TO SIDE ROAD (SOUTH) AND P.I. PER RECORD COUNTY PLANS. PRIOR TO RESURFACING, CORNER LOCATION TEMP. REF. PER RTK GPS PROJECT THEN MILLED EXISTING ACC SURF. & ADDED 2" HMA SURFACE COURSE. AFTER RESURF. PROJECT, NO SOUNDING REMAINED @ CORNER LOCATION. RESET 2-1/2"L. P.K. WITH STEEL WASHER @ CORNER LOCATION. ALSO ESTABLISHED "P.K." NAIL (WITHOUT WASHER) @ HISTORICAL PLAN REFERENCE TO P.O.T. / INT. LOCATED ± 15.5' WEST OF LAND CORNER.

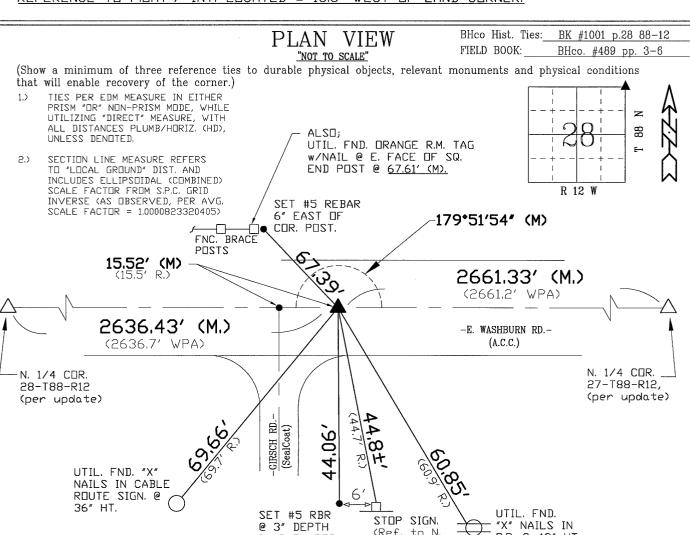

(Ref. to N.

unstable)


Face,

Post

FIELD SURVEY:

PREPARED BY:

CERTIFICATION

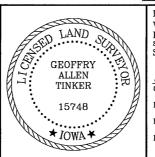

S.P.C., Ia. N. Zone, USft

(NAD83-2007 "BHco07", RTK Obs.)

N=3616329.15' E=5261592.23'

I hereby certify that this land surveying document was prepared and the related survey work was performed by me or under my direct personal supervision and that I am a duly licensed Land Surveyor under the laws of the State of Iowa.

IN SHOULDER,

W. DF

LOC. 6' W.

10/29/2010 Wea Aller

15748 License Number_

My license renewal date is December 31, 2010

Pages or sheets covered by this seal:

This Land Corner Certificate Only.

<u>LIST</u>	CORNERS	TO BE II	NDEXED	
<u>Corner</u>	Section	- <u>Town</u>	iship –	<u>Range</u>
N.E. Cor.	28	88	N	12 W
N.W. Cor.	27	88	N	12 W
S.E. Cor.	21	88	N	12 W
S.W. Cor.	22	88	N	12 W
INDEX OF ABBREVIATIONS				
(M) = "Measured" Dimension "NP" = Reflectorless EDM Meas. (P) = "Platted" Dimension "MLM" = Indirect Measure				
(P) = "Platted" Dimension "MLM" = Indirect Measure				

G.T. & J.Z.

G.T. & T.K.

6/16/09

8/11/10

"X" NAILS IN P.P. @ 43" H1

"Platted" Dimension
"Record" Dimension
"Calculated" Dimension
Iowa Geodetic Survey "CM" = Concrete Monument
"SM" = Survey Marker Spike/Tag 'WPA"


"S" = Iowa Geodetic Survey

"A" = Works Progress Admin. Survey

= per George Miller Survey (BHco Surveyor 1858-1860)

= per John Ball Survey (BHco Surveyor 1866-1891)

= per Nathan Barber Survey (BHco Surveyor 1908-1931)