

PROOF FILED FOR RECORD MAR 20, 2006, AT 10:00A. M. FEE 1-5.00-1.00/

COMPARED

Patricia A. Lero

BLACK HAWK COUNTY RECORDER

KESS & ASSOCIATES INC

Kirk D. Eschliman, P.L.S. Iowa Lic. No. 9961, 723 Broadway Street, Waterloo, Iowa 50703 - Phone: 319-234-0509

UNITED STATES PUBLIC LAND SURVEY CORNER CERTIFICATE
OF

FEE BK. 2005-23274

LAND SURVEY MONUMENTS SITUATED IN SECTION TWENTY-EIGHT (28), TOWNSHIP EIGHTY-EIGHT (88) NORTH
RANGE TWELVE (12) WEST, OF THE FIFTH PRINCIPAL MERIDIAN, BLACK HAWK COUNTY, IOWA.
PREVIOUSLY RECORDED IN (NOT PREVIOUSLY RECORDED) (BOOK, PAGE, DOCUMENT NUMBER, ETC.) IN THE COUNTY RECORDER'S OFFICE.

(SHOW REASON FOR PREPARING THIS CERTIFICATE, THE EVIDENCE AND DETAILED PROCEDURES USED IN ESTABLISHING THE CORNER POSITIONS AND MONUMENTATION FOUND OR PLACED.)


MONUMENT DESCRIPTION AND REMARKS:

CURRENT SECTION CORNER CERTIFICATE NOT ON FILE IN THE BLACK HAWK COUNTY RECORDER'S OFFICE.

FOUND #5 REBAR, EVEN WITH SURFACE OF ASPHALT WASHBURN ROAD.

FOR USE IN REFERENCED FIELD SURVEY, W 1/2, SW 1/4, SECTION 28.

PLAN - VIEW

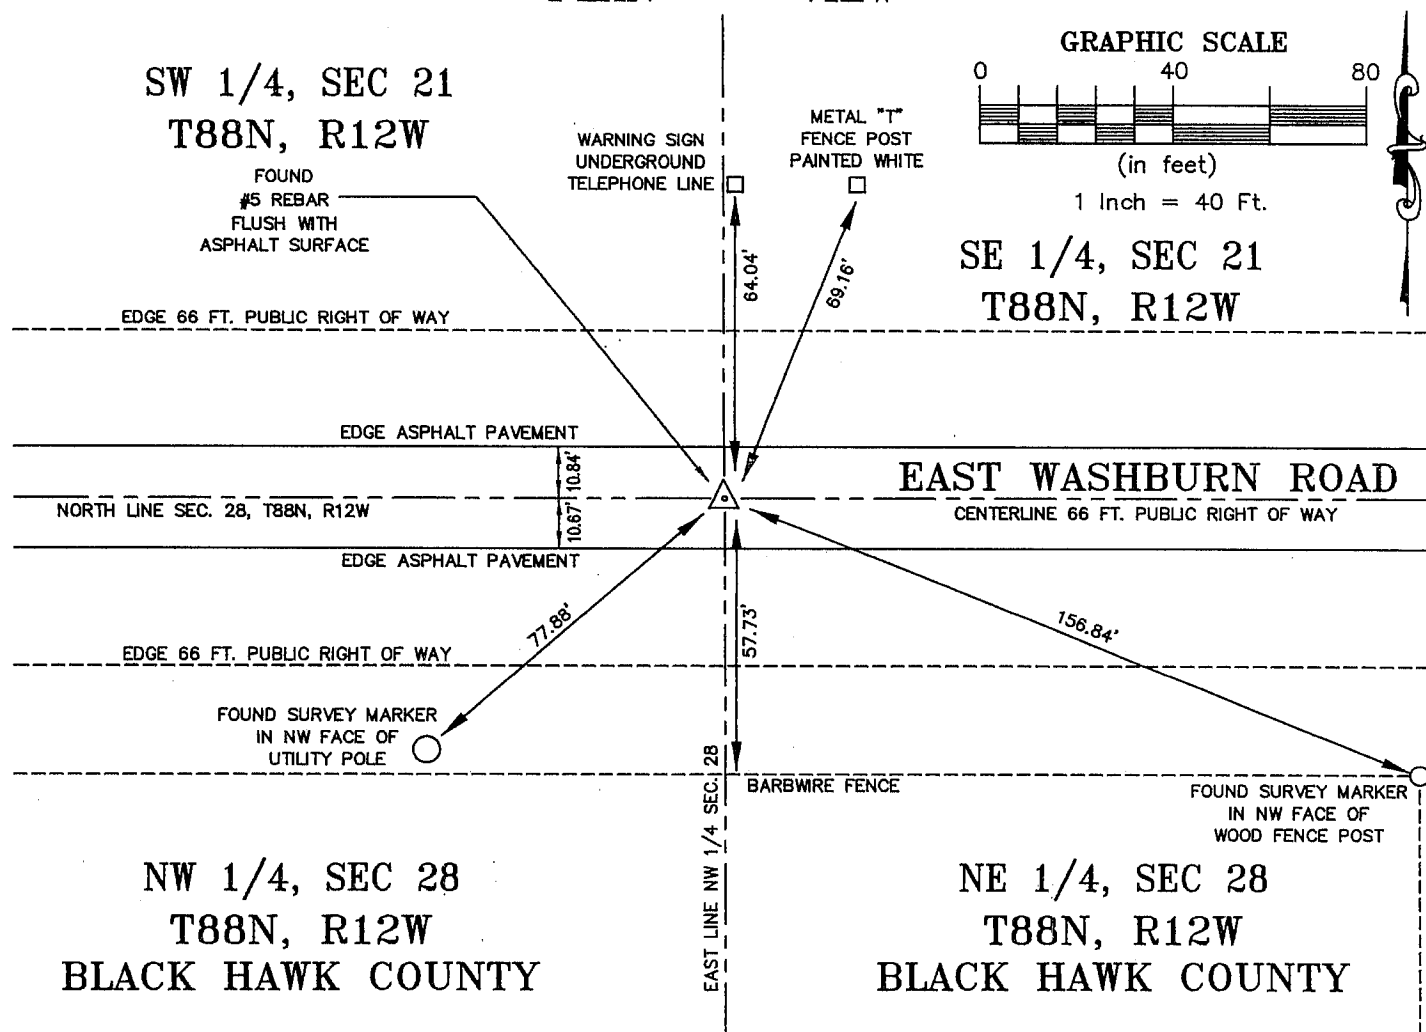
I HEREBY CERTIFY THAT THIS LAND SURVEYING DOCUMENT
WAS PREPARED AND RELATED SURVEY WORK WAS
PERFORMED BY ME OR UNDER MY DIRECT PERSONAL
SUPERVISION AND THAT I AM A DULY LICENSED LAND
SURVEYOR UNDER THE LAWS OF THE STATE OF IOWA.DATE: 03/20/2006
KIRK D. ESCHLIMAN, P.L.S. IOWA LIC. NO. 9961
MY LICENSE RENEWAL DATE IS DECEMBER 31, 2007
PAGES OR SHEETS COVERED BY THIS SIGNATURE & SEAL: SHEET 1 OF 1FOR: MARLYS J. McDONALD & RICHARD L. FOULK
400 FIRST STREET
WASHBURN, IOWA 50706REQ. BY: KENNY JOHNSON
WASHBURN, IOWAKESS & ASSOCIATES, INC.
PROFESSIONAL LAND SURVEYORS : 723 BROADWAY, WATERLOO, IOWA 50703-5811

DATE: 03/15/2006 C.A.D.D. FILE: 06A16SCC2.DWG PROJECT NO.: 06A16

List of corners to be indexed:

Corners	Section	Township	Range
NW	28	T88N	R12W

SECTION 28

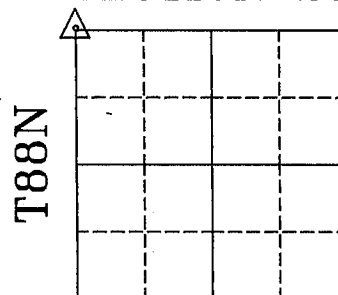

R12W