

Number: 202400005810  
Recorded: 11/1/2023 at 10:02:39.0 AM  
County Recording Fee: \$7.00  
Iowa E-Filing Fee: \$3.00  
Combined Fee: \$10.00  
Revenue Tax:  
Sandie L. Smith, RECORDER  
Black Hawk County, Iowa

Prepared by & Return to: Isaiah M. Reicks, HRS, LLC, 2206 East Bremer Avenue, Waverly, IA 50677, Phone 319-483-5187

United States Public Land Survey Corner Certificate

Land Survey Monument situated in  
Section 32, Township 88 North, Range 12 West of the Fifth Principal Meridian, Black Hawk County, Iowa.  
Not on file in the County Recorder's Office.

This certificate is being prepared in compliance with Iowa Code Chapter 355.11 because: {  
☒ There is no certificate on file for this corner.  
☐ There are no longer three valid ties of record.  
☐ There are changes to reference ties of record.  
☐ There is change of monumentation of record.  
☐ To clarify description of record monument (ties).


Monument Description and Remarks:

Southwest Corner of the NW 1/4 - NE 1/4: Calculated Position equidistant and on line between the North 1/4 Corner and the Center of said Section. Corner falls in a Wood Corner Post. Set 5/8"Ø Rebar w/Yellow Plastic Cap PLS 22468 55.00' East of the Corner on the Quarter-Quarter Section Line and 55.00' South of the Corner on the Quarter Section Line as Witness Corners.

An extensive search of all of the records within the County offices was performed as part of the section corner recovery.  
There were no records located of the perpetuation of a monument at this corner.

Plan View - Not to Scale

(Show a minimum of three reference ties to durable physical objects, relevant monuments and physical conditions that will enable recovery of the corner.)

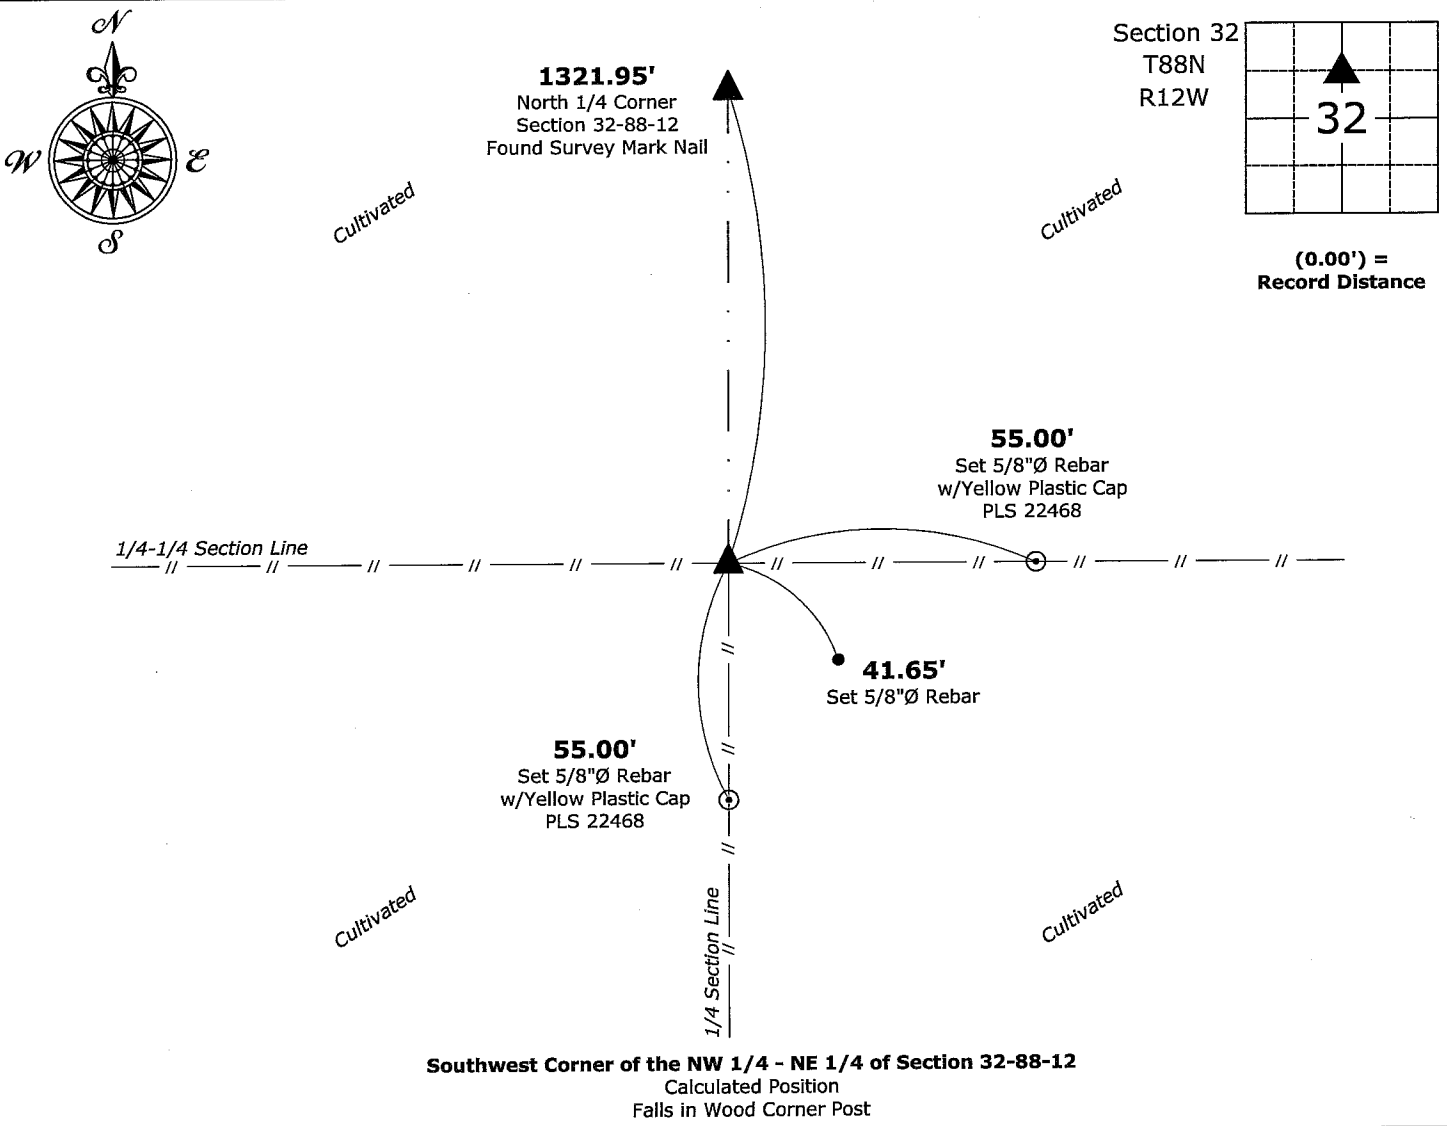

ISAIAH M. REICKS  
22468

I hereby certify that this land surveying document was prepared and the related survey work was performed by me or under my direct personal supervision and that I am a duly licensed Land Surveyor under the laws of the State of Iowa.

*Isaiah M. Reicks*  
Isaiah M. Reicks Date: 10-31-23

License number 22468  
My license renewal date is December 31, 2023.  
Sheets covered by this seal: Individual sheet only

List Corner to be Indexed

Corner	Section	Township	Range
SW-NW-NE	32	88	12

Project Number: 2023-564  
FB:Black Hawk 11, Page(s) 22