Number: 202400005807

Recorded: 11/1/2023 at 10:02:39.0 AM

County Recording Fee: \$7.00 Iowa E-Filing Fee: \$3.00 Combined Fee: \$10.00

Revenue Tax:

Sandie L. Smith, RECORDER Black Hawk County, Iowa

ed by & Return to: Isaiah M. Reicks, HRS, LLC, 2206 East Bremer Avenue, Waverly, IA 50677, Phone 319-483-5187

United States Public Land Survey Corner Certificate

Land Survey Monument situated in

Section 32, Township 88 North, Range 12 West of the Fifth Principal Meridian, Black Hawk County, Iowa. On file in Document #2007-05871 in the County Recorder's Office.

This certificate is being prepared in compliance with Iowa Code Chapter 355.11 because:

There is no certificate on file for this corner. There are no longer three valid ties of record. There are changes to reference ties of record. There is change of monumentation of record.


To clarify description of record monument (ties).

Monument Description and Remarks:

Southwest Corner:

Found 1/2"Ø Iron Pin w/Red Plastic Cap PLS 16775 with information obtained from the previously recorded Section Corner Certificate.

Plan View - Not to Scale

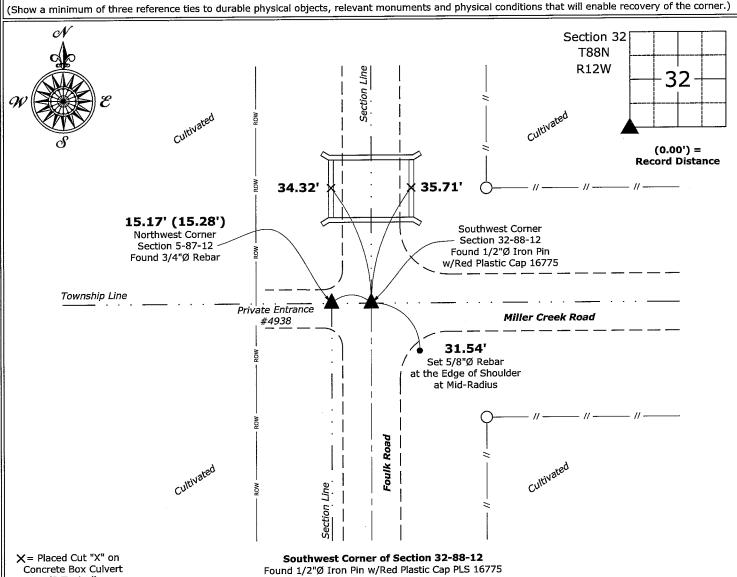



(2 Typical)

I hereby certify that this land surveying document was prepared and the related survey work was performed by me or under my direct personal supervision and that I am a duly licensed Land Surveyor under the laws of the State of Iowa.

Isaiah M. Reicks 10-31-23 Date:

License number 22468 My license renewal date is December 31, 2023. Sheets covered by this seal: Individual sheet only

Corner	Section	Township	Range	
sw	32	88	12	
Project Number: 2023-564				
FB:Black Hawk 11, Page(s) 23				

List Corner to be Indexed

File: I:__Projects - WO\County Control Systems_WO\BLACK HAWK\BHCO-23\BHCO-23-2023.dwg, 10/31/2023 3:03:18 PM