

Number: 202400005808
 Recorded: 11/1/2023 at 10:02:39.0 AM
 County Recording Fee: \$7.00
 Iowa E-Filing Fee: \$3.00
 Combined Fee: \$10.00
 Revenue Tax:
 Sandie L. Smith, RECORDER
 Black Hawk County, Iowa

Prepared by & Return to: Isaiah M. Reicks, HRS, LLC, 2206 East Bremer Avenue, Waverly, IA 50677, Phone 319-493-5187

United States Public Land Survey Corner Certificate

Land Survey Monument situated in
 Section 32, Township 88 North, Range 12 West of the Fifth Principal Meridian, **Black Hawk County, Iowa.**
 On file in **Document #2007-05869** in the County Recorder's Office.

This certificate is being prepared in compliance with Iowa Code Chapter 355.11 because: {



- There is no certificate on file for this corner.
- There are no longer three valid ties of record.
- There are changes to reference ties of record.
- There is change of monumentation of record.
- To clarify description of record monument (ties).

Monument Description and Remarks:

West 1/4 Corner:
 Found 1.5"Ø Iron Pipe with information obtained from the previously recorded Section Corner Certificate. Set 60d Nail in the Center of Pipe.

Plan View - Not to Scale

(Show a minimum of three reference ties to durable physical objects, relevant monuments and physical conditions that will enable recovery of the corner.)

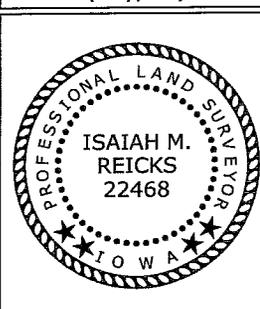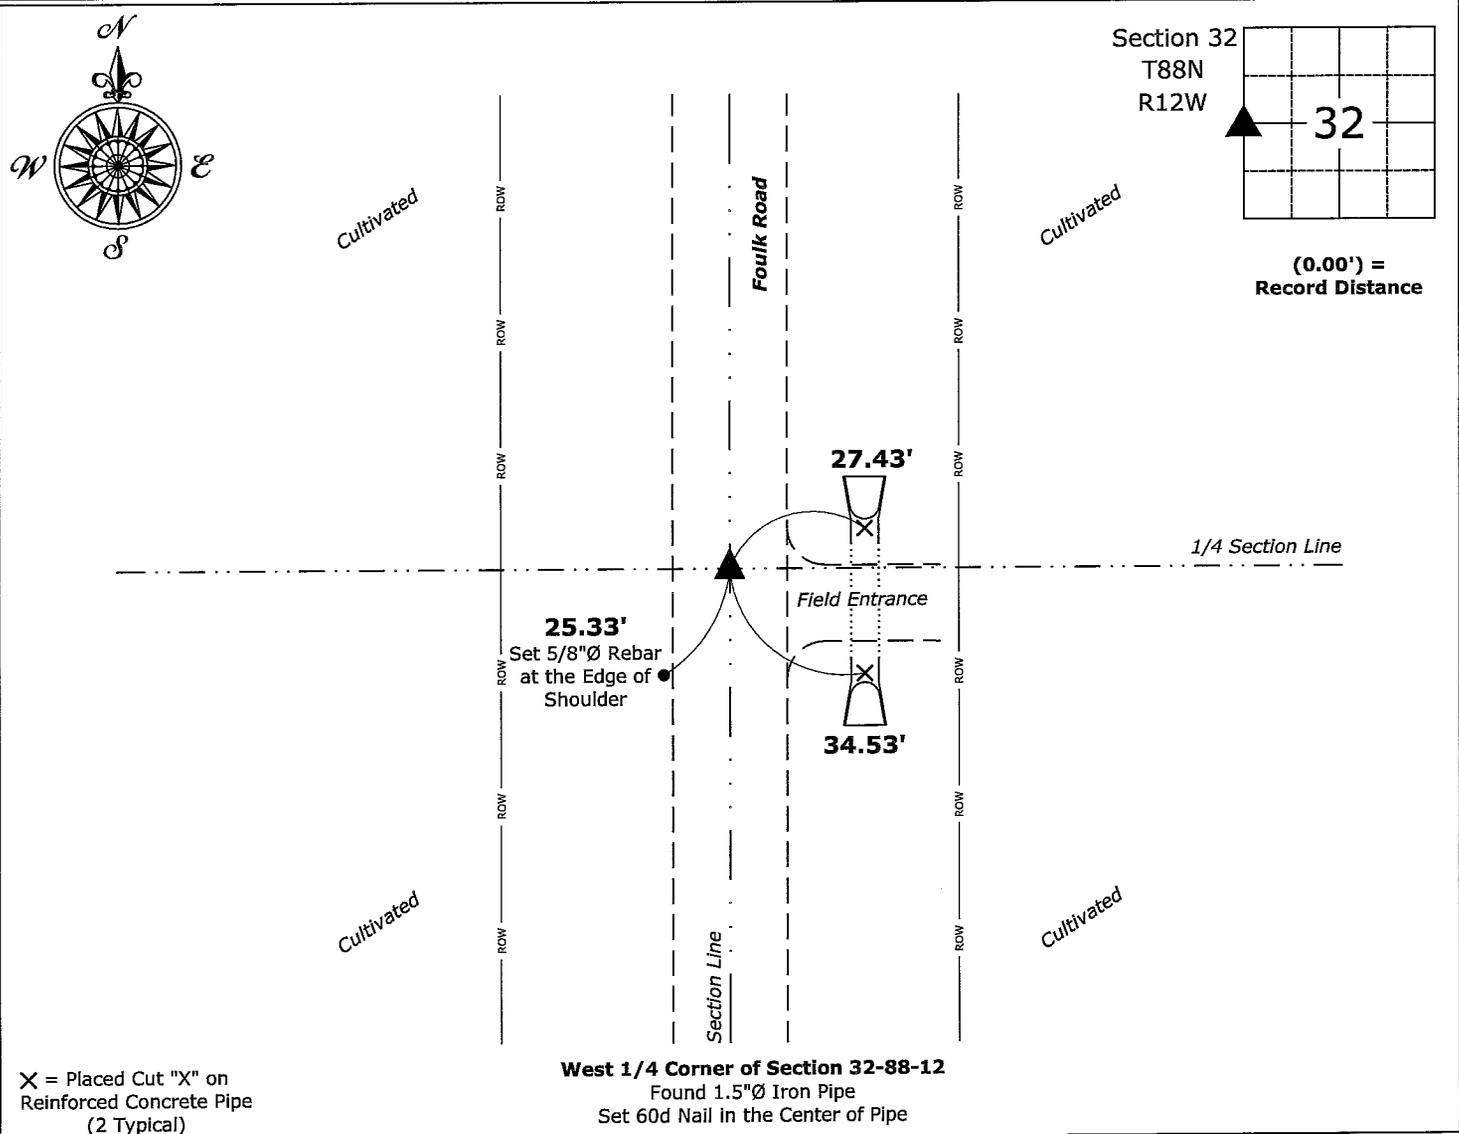

I hereby certify that this land surveying document was prepared and the related survey work was performed by me or under my direct personal supervision and that I am a duly licensed Land Surveyor under the laws of the State of Iowa.

Isaiah M. Reicks
 Isaiah M. Reicks Date: 10-31-23

License number 22468
 My license renewal date is December 31, 2023.
 Sheets covered by this seal: Individual sheet only

List Corner to be Indexed			
Corner	Section	Township	Range
W 1/4	32	88	12
Project Number: 2023-564			
FB:Black Hawk 11, Page(s) 23			