PROOF, FILED FOR RECORD AUG 20

2003 AT 11:00A. M. FEE N/C

COMPARED

BLACK HAWK COUNTY RECORDER

BLACK HAWK COUNTY ENGINEER

PREPARED BY:

BLACK HAWK COUNTY ENGINEERS OFFICE 316 E. FIFTH STREET, ROOM 211 WATE

WATERLOO, IOWA 50703

PH.# (319) 833-3008 FAX.# (319) 833-3139

SLSI 9-94 CERT 12-96

UNITED STATES PUBLIC LAND SURVEY CORNER CERTIFICATE OF


Land Survey Monuments situated in Section\_ Township 88 N Range 12 W , of the Fifth Principal Meridian, BLACK HAWK County, Iowa. Previously recorded in Misc. Book N/A, Page N/A, in County Recorder's Office.

(Show reason for preparing this certificate, the evidence and detailed procedures used in establishing the corner positions and monumentation found or placed.)


N.E. CORNER SECTION 33-88-12: Monument Description and Remarks: \_ FOUND 7/8" SMOOTH STEEL PIN @ 3" DEEP ALIGNED WITH FENCE WEST. E. 1/4 COR. SECTION 33-88-12: FND. #5 RBR. PRIOR TO RD. EXT. PROJECT. RE-EST. 38"L X 5/8" RBR. w/ 2" ALUM. CAP "BH CO. LAND COR.", LOCATED 3.5' N. DF FENCE TO E. & 21.0' E. DF E. ROAD EDGE. UTIL, FOR N. 1/16TH CONER EST., R.O.W. ACQUISTIONS, & "RECORD OF SURVEY" FOR SAID SECTION

## PLAN – VIEW

(Show a minimum of three reference ties to durable physical objects, relevant monuments and physical conditions that will enable recovery of the corner.)

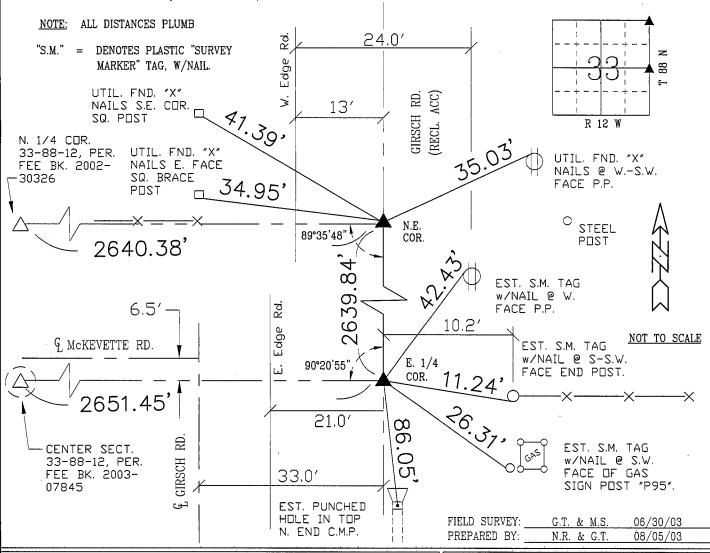

## <u>CERTIFICATION</u>

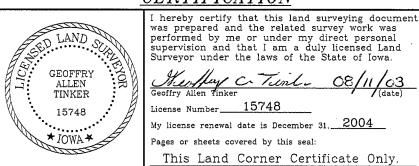

## LIST CORNERS TO BE INDEXED

Corner	Section -	- <u>Township</u>	- <u>Range</u>
NE Cor.	33	88 N	12 W
NW Cor.	34	88 N	12 W
SE Cor.	28	88 N	12 W
SW Cor.	27	88 N	12 W
E. 1/4.	33	88 N	12 W
W. 1/4	34	88 N	12 W