Number: 202400005813

Recorded: 11/1/2023 at 10:02:40.0 AM

County Recording Fee: \$7.00 lowa E-Filing Fee: \$3.00 Combined Fee: \$10.00

Revenue Tax:

Sandie L. Smith, RECORDER Black Hawk County, Iowa

Prepared by & Return to: Isaiah M. Reicks, HRS, LLC, 2206 East Bremer Avenue, Waverly, IA 50677, Phone 319-483-5187

United States Public Land Survey Corner Certificate

Land Survey Monument situated in

Section **33**, Township **88** North, Range **12** West of the Fifth Principal Meridian, **Black Hawk** County, Iowa. On file in **Document #2004-06211** in the County Recorder's Office.

This certificate is being prepared in compliance with Iowa Code Chapter 355.11 because:


□ There is no certificate on file for this corner.
□ There are no longer three valid ties of record.
□ There are changes to reference ties of record.
□ There is change of monumentation of record.
□ To clarify description of record monument (ties).

Monument Description and Remarks:

Northeast Corner: Found 3/4"Ø Iron Pin with information obtained from the previously recorded Section Corner Certificate.

Plan View - Not to Scale

(Show a minimum of three reference ties to durable physical objects, relevant monuments and physical conditions that will enable recovery of the corner.)

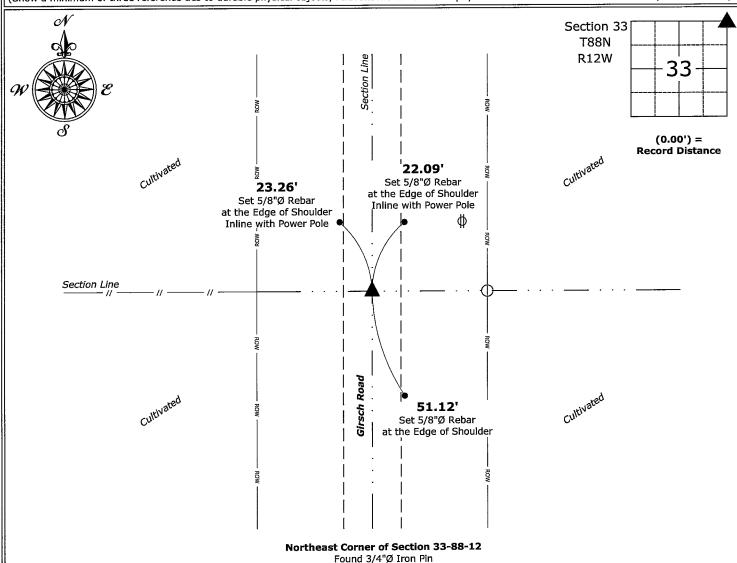



I hereby certify that this land surveying document was prepared and the related survey work was performed by me or under my direct personal supervision and that I am a duly licensed Land Surveyor under the laws of the State of Iowa.

Isaah M. Reicks Date:

License number 22468

My license renewal date is December 31, 2023. Sheets covered by this seal: Individual sheet only

List Corner to be Indexed			
Corner	Section	Township	Range
NE	33	88	12

Project Number: 2023-564 FB:Black Hawk 11, Page(s) 22 File: I: Projects - WO\County Control Systems_WO\BLACK HAWK\BHCO-23\BHCO-23-2023.dwg, 10/31/2023 3:29:15 PM