Number: 202400005816

Recorded: 11/1/2023 at 10:02:40.0 AM

County Recording Fee: \$7.00 Iowa E-Filing Fee: \$3.00 Combined Fee: \$10.00

Revenue Tax:

Sandie L. Smith, RECORDER Black Hawk County, Iowa

Prepared by & Return to: Isaiah M. Reicks, HRS, LLC, 2206 East Bremer Avenue, Waverly, IA 50677, Phone 319-483-5187

United States Public Land Survey Corner Certificate

Land Survey Monument situated in

Section 33, Township 88 North, Range 12 West of the Fifth Principal Meridian, Black Hawk County, Iowa. Not on file in the County Recorder's Office.

This certificate is being prepared in compliance with Iowa Code Chapter 355.11 because:

There is no certificate on file for this corner. There are no longer three valid ties of record. There are changes to reference ties of record. There is change of monumentation of record. □ To clarify description of record monument (ties).


Monument Description and Remarks:

Southeast Corner of the SW 1/4 - SW 1/4: Set 1"Ø Bronze Survey Marker PLS 22468 equidistant and on line between the Southwest Corner and the South Quarter Corner of Section 33-88-12.

An extensive search of all of the records within the County offices was performed as part of the section corner recovery. There were no records located of the perpetuation of a monument at this corner.

See Retracement Plat of Survey, as recorded in Document #2024-04947, on file in the County Recorder's Office for further information.

Plan View - Not to Scale

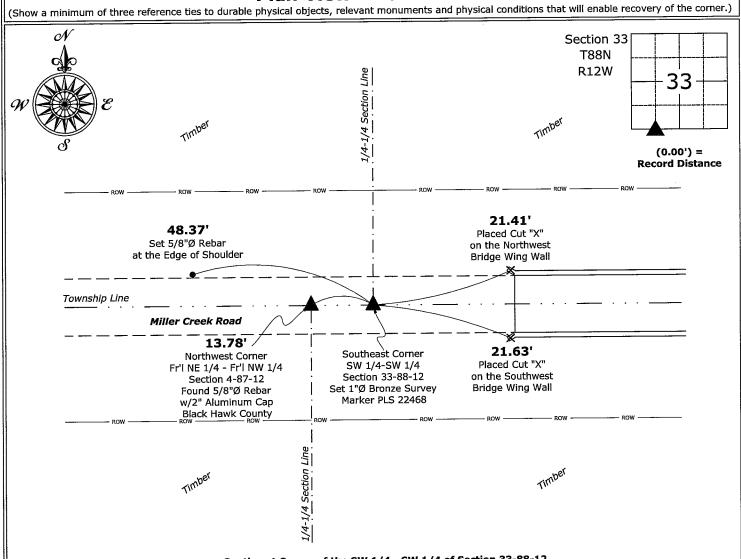

Southeast Corner of the SW 1/4 - SW 1/4 of Section 33-88-12 Set 1"Ø Bronze Survey Marker PLS 22468



I hereby certify that this land surveying document was prepared and the related survey work was performed by me or under my direct personal supervision and that I am a duly licensed Land Surveyor under the laws of the State of Iowa.

Isaiah M. Reicks -10-31-23 Date:

License number 22468

My license renewal date is December 31, 2023. Sheets covered by this seal: Individual sheet only

List Corner to be indexed			
Corner	Section	Township	Range
SE-SW-SW	33	88	12

Project Number: 2023-564 FB:Black Hawk 11, Page(s) 24 I:__Projects - WO\County Control Systems_WO\BLACK HAWK\BHCO-23\BHCO-23-2023.dwg, 10/31/2023 3:32:05 PM