

Patricia J. Less

BLACK HAWK COUNTY RECORDER

ENV TEKIPPE ENGINEERING PC 128 SOUTH VINE ST WEST UNION IA 52175

TeKIPPE ENGINEERING, P.C., 128 South Vine Street, West Union, Iowa 52175 Phone (563) 422-5131

UNITED STATES PUBLIC LAND SURVEY CORNER CERTIFICATE

OF


Land Survey Monuments situated in Section 34 , Township 88 North, Range 12 West of the Fifth Principal Meridian, BLACK HAWK County, Iowa.Previously recorded in none in County Recorder's Office.
(book, page, document number, etc.)

(Show reason for preparing this certificate, the evidence and detailed procedures used in establishing the corner positions and monumentation found or placed.)

Monument Description and Remarks: SE Corner Section 34 T88N R12W: Found concrete monument w/brass cap, 6" deep. Set 1/2"Ø x 4' rebar w/2"Ø aluminum cap PLS 16961 at North side of monument, 0.40' from center of brass cap. Monument was found with information obtained from the Black Hawk County Engineer's Office in the Field Book Section Corner Ties, Section 34, T88N, R12W.

PLAN - VIEW

(Show a minimum of three reference ties to durable physical objects, relevant monuments and physical conditions that will enable recovery of the corner.)

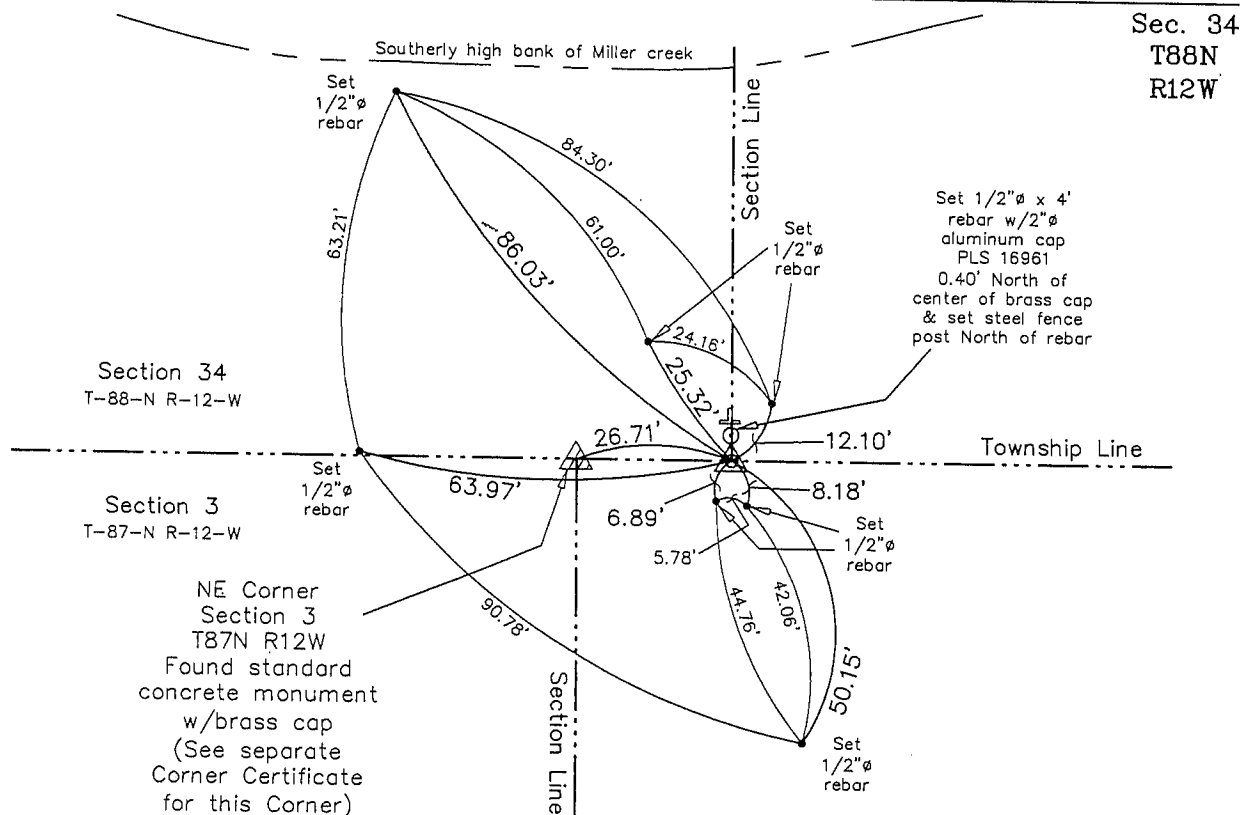

SE Corner Section 34 T88N R12W
Found concrete monument w/brass cap, 6" deep.
Set 1/2"Ø x 4' rebar w/2"Ø aluminum cap PLS 16961 at North side
of monument, 0.40' from center of brass cap.



I hereby certify that this land surveying document was prepared and the related survey work was performed by me or under my direct personal supervision and that I am a duly licensed Land Surveyor under the laws of the State of Iowa.

Michael J. Shimak January 19, 2005
Michael J. Shimak Date

License number 16961

My license renewal date is December 31, 2005.

Sheets covered by this seal: Individual

List Corners to be Indexed			
Corners	Section	Twp.	Range
SE	34	88N	12W

Project Number 04118.LS
FB. NRCS #3 PG. 12-22

X:\Section Corners\Sec. 34\34-88-12y.dwg