
BLACK HAWK COUNTY IOWA:SS **012578**FILED FOR RECORD Dec 8 , 1999 AT
1:00 P M., AND RECORDED IN BOOK 336

OF MISC PAGE 576

RECORDER

FEE 1-5.00x
PAUL HELLAND
1107 TECHNOLOGY PKWY CEDAR FALLS IA 50613

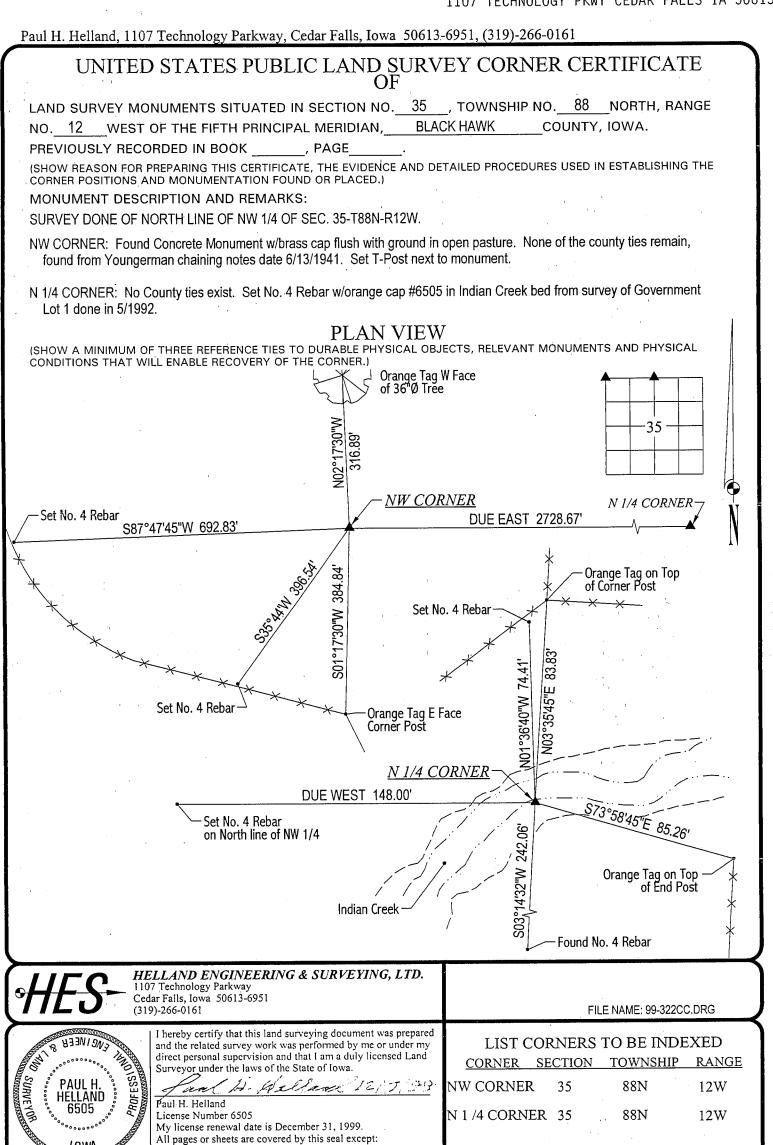

/OWA

336 page 576

Rec