

ENV BRAIN ENGINEERING INC  
1540 MIDLAND CT NE  
CEDAR RAPIDS, IA 52402-1922

I  
P  
Z

Document Number: 2007027503  
Date: Jun 25, 2007 4:30:00 pm  
Aud Fee: 0.00 Rec Fee: 5.00  
Trans Tax: 0.00 Rec Management Fee: 1.00  
E-Com Fee: 1.00 Non-Standard Page Fee: 0.00  
Filed for record in Black Hawk County, Iowa  
Judith A. McCarthy, County Recorder

PREPARED BY  
STEPHEN MICHAEL BRAIN, BRAIN ENGINEERING, INC., 1540 MIDLAND COURT NE, CEDAR RAPIDS, IOWA PH. (319) 294-9424



# UNITED STATES PUBLIC LAND SURVEY CORNER CERTIFICATE

LAND SURVEY MONUMENTS SITUATED IN SECTION 1, TOWNSHIP 88 NORTH  
RANGE 13 WEST OF THE 5TH P.M., BLACKHAWK COUNTY, IOWA.


NO SCALE



N 1/4 CORNER

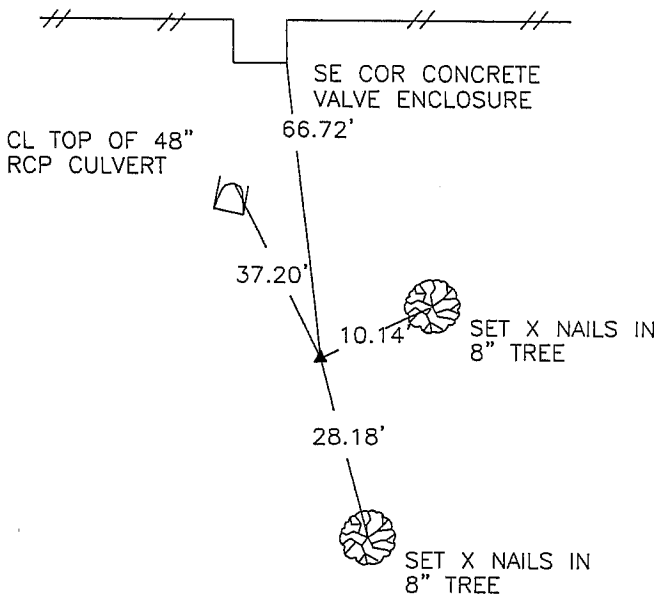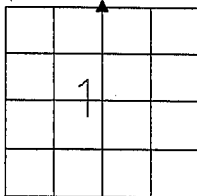


NO SCALE

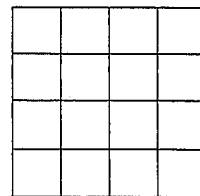

PREVIOUSLY RECORDED IN BOOK \_\_\_\_\_ PAGE \_\_\_\_\_  
MONUMENT DESCRIPTION AND HOW ESTABLISHED \_\_\_\_\_  
FOUND IDOT ALUMINUM MONUMENT WITH MAGNET INSERTS  
4" BELOW SURFACE.

PREVIOUSLY RECORDED IN BOOK \_\_\_\_\_ PAGE \_\_\_\_\_  
MONUMENT DESCRIPTION AND HOW ESTABLISHED \_\_\_\_\_

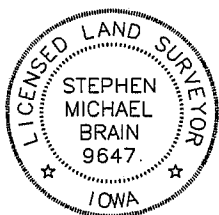

I hereby certify that this land surveying document  
and the related survey work was performed by me  
or under my direct personal supervision and that  
I am a duly licensed Land Surveyor under the laws  
of the State of Iowa.  
Signed Stephen Michael Brain Date 6/22/07  
Stephen Michael Brain, L.S.  
My License Renewal Date is December 31, 2008  
License Number 9647  
Pages or sheets covered by this seal: 1/1

- ☒ A.THERE IS NO CERTIFICATE FOR THE CORNER ON FILE  
WITH THE RECORDER OF THE COUNTY IN WHICH THE  
CORNER IS LOCATED  
☐ B.THE SURVEYOR IN RESPONSIBLE CHARGE OF THE LAND  
SURVEYING ACCEPTS A CORNER POSITION WHICH DIFFERS  
FROM THAT SHOWN IN THE PUBLIC RECORDS OF THE  
COUNTY IN WHICH THE CORNER IS LOCATED.  
☐ C.THE CORNER MONUMENT IS REPLACED OR MODIFIED IN  
ANY WAY.  
☐ D.THE REFERENCE TIES REFERRED TO IN AN EXISTING  
PUBLIC RECORD ARE NOT CORRECT.

CORNERS TO BE INDEXED  
CORNER SECTION TOWNSHIP RANGE  
N 1/4 CORNER 1 T88N R13W

**BRAIN ENGINEERING, INC.**  
1640 MIDLAND COURT NE  
CEDAR RAPIDS, IOWA 52402  
(319) 294-9424

366607.50  
✓ RCH