

UNITED STATES PUBLIC LAND SURVEY CORNER CERTIFICATE

OF


Land Survey Monuments situated in Section 1, Township 88N, Range 13W, of the Fifth Principal Meridian, BLACK HAWK County, Iowa.
 Previously recorded in N/A in County Recorder's Office.
 (book, page, document number, etc.)

(Show reason for preparing this certificate, the evidence and detailed procedures used in establishing the corner positions and monumentation found or placed.)

Monument Description and Remarks: FOUND STD. CONC. MON. 4" DEEP W/ORANGE
STEEL FE. POST @ EAST EDGE OF MONUMENT.

PLAN - VIEW

(Show a minimum of three reference ties to durable physical objects, relevant monuments and physical conditions that will enable recovery of the corner.)

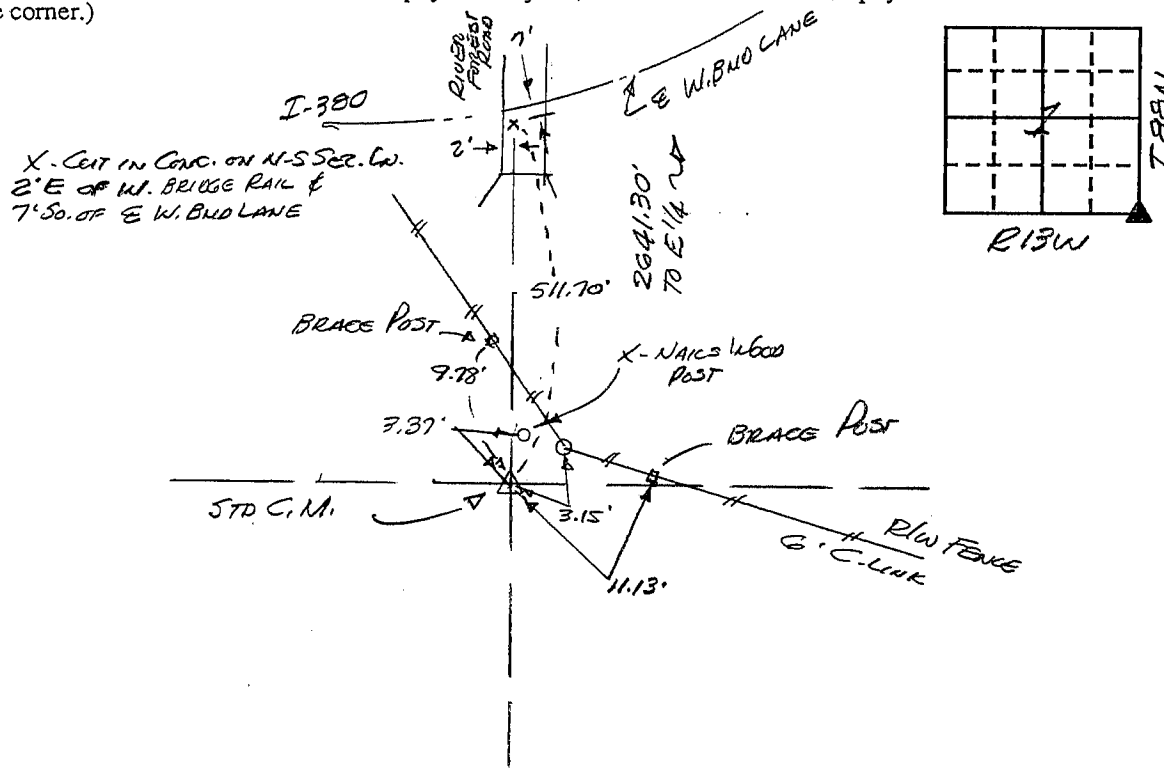

WAYNE CLAASSEN ENGINEERING
 AND SURVEYING, INC.
 2709 UNIVERSITY AVE.
 P.O. BOX 898
 WATERLOO, IA 50704

399-6

I hereby certify that the survey work was completed and this certificate was prepared by me or under my direct personal supervision and that I am a duly registered land surveyor under the laws of the state of Iowa.

Signature: F. William King

Name typed or printed: F. WILLIAM KING

Date: 7-21-1993 Reg. No. 8033

Corners	List Corners to be Indexed	Section	Twp	Range
SE	1	88N	13W	
NE	12	88N	13W	

SEAL



MISC. BK. 307 p. 316