

SC
MISC
INDEX
MARGIN
PROOF
COMPARE

BLACK HAWK COUNTY IOWA:SS 019417
FILED FOR RECORD MAR 28, 2001 AT
3:00 P. M. AND RECORDED IN BOOK 342
OF MISC PAGE 160
Catherine J. Lass RECORDER
FEE 1-5.00/
WAYNE CLAASSEN ENGINEERING AND SURVEYING, INC.

WAYNE CLAASSEN ENGINEERING AND SURVEYING, INC.
P.O. BOX 898 WATERLOO, IOWA 50704-0898

PHONE: (VOICE) 319-235-6294
(FAX) 319-235-0028

UNITED STATES PUBLIC LAND SURVEY CORNER CERTIFICATE


and Survey Monuments situated in Section 3, Township 88N, Range 13W, of the Fifth Principal Meridian, BLACK HAWK County, Iowa.
Previously recorded in N/A in County Recorder's Office.
(book, page, document number, etc.)

Show reason for preparing this certificate, the evidence and detailed procedures used in establishing the corner positions and monumentation found or placed.)

Monument Description and Remarks FOUND 4" Ø ALUM. DISK OF X IN A/C PATCH AREA
OF P.C. CONC. PAV'T. ON N-S & HAMMOND AVE & E SAN MARIAN FRONTAGE
ROAD TO WEST 2 PER. PLAT SURVEY ADDITION, WATERLOO.

PLAN - VIEW

Show a minimum of three reference ties to durable physical objects, relevant monuments and physical conditions that will enable recovery of the corner.)

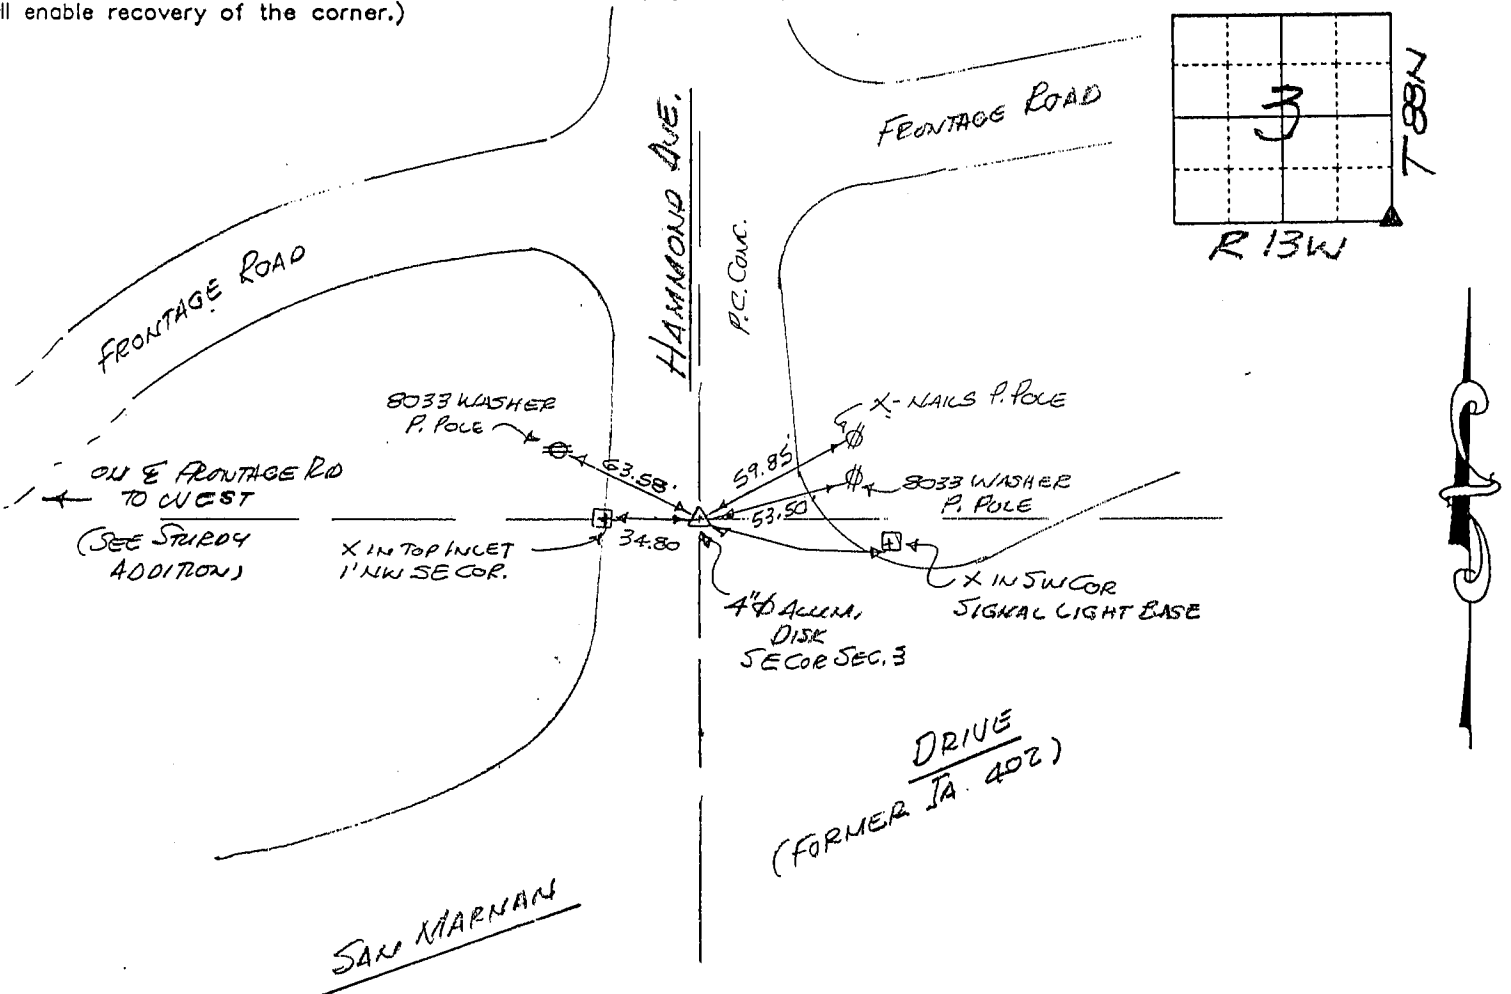


523-66

I hereby certify that the survey work was completed and this certificate was prepared by me or under my direct personal supervision and that I am a duly licensed land surveyor under the laws of the state of Iowa.

Signature: F. William King
(Name typed or printed:) F. WILLIAM KING
Date: MARCH 22, 2001 Lic. No. 8033

SEAL

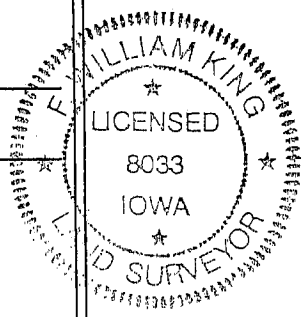

List Corners to be Indexed

Corners	Section	Twp	Range
SE	3	88N	13W

BOOK MISC 0342 160