

PROOF

FILED FOR RECORD JUN 25, 2003, AT 9:00 A.M. FEE 1-5.00/

COMPARED

Patricia A. Less

BLACK HAWK COUNTY RECORDER

WAYNE CLAASSEN ENGINEERING AND SURVEYING INC

WAYNE CLAASSEN ENGINEERING AND SURVEYING, INC.
P.O. BOX 898 WATERLOO, IOWA 50704-0898PHONE: (VOICE) 319-235-6294
(FAX) 319-235-0028

UNITED STATES PUBLIC LAND SURVEY CORNER CERTIFICATE


Land Survey Monuments situated in Section 7, Township 89N, Range 13W, of the Fifth Principal Meridian, Black Hawk County, Iowa.
Previously recorded in 111A in County Recorder's Office.
(book, page, document number, etc.)

(Show reason for preparing this certificate, the evidence and detailed procedures used in establishing the corner positions and monumentation found or placed.)

Monument Description and Remarks Center Section - set 1/2" x 24 Rebar over 2' x 3'
Rock with x cut on westerly side, at intersection of 1/4 Section Lines.
Set SW COR NW 1/4 NW 1/4 SE 1/4 at 655.14' South of center section (1/2" x 24 rebar &
yellow cap 8033.

PLAN - VIEW

(Show a minimum of three reference ties to durable physical objects, relevant monuments and physical conditions that will enable recovery of the corner.)

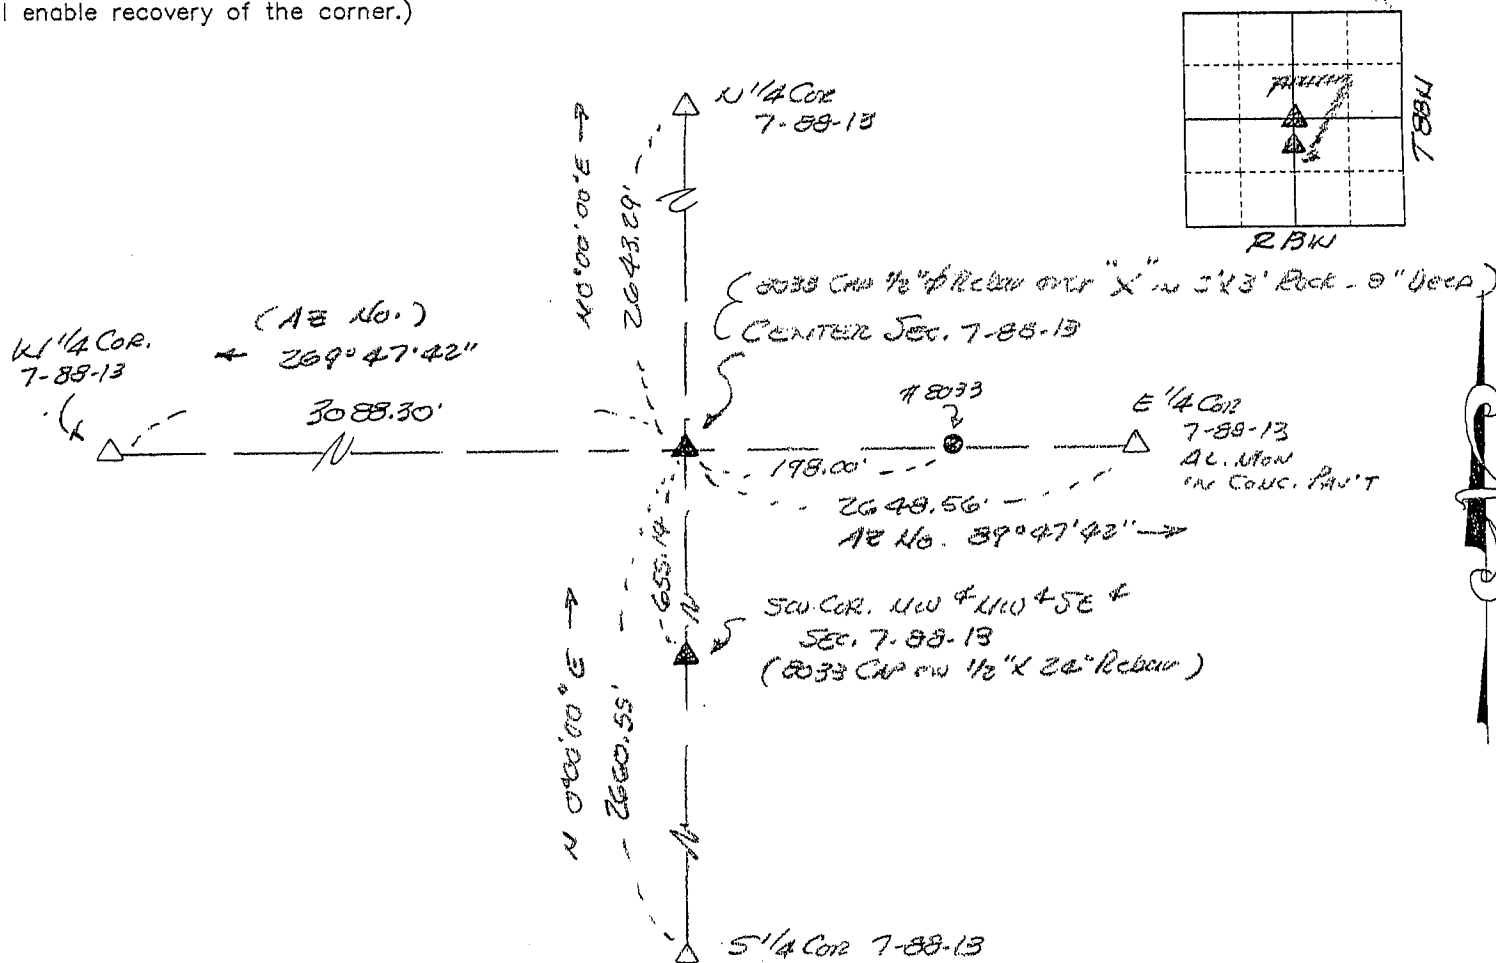

584-47

I hereby certify that the survey work was completed and this certificate was prepared by me or under my direct personal supervision and that I am a duly licensed land surveyor under the laws of the state of Iowa.

Signature:

F. William King(Name typed or printed:) F. William King


Date:

June 23, 2003

Lic. No.

8033

SEAL

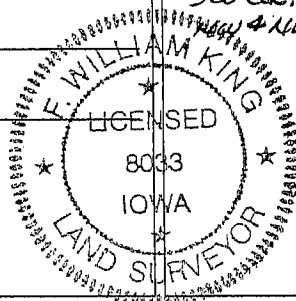

List Corners to be Indexed

Corners	Section	Twp	Range
Center	7	89N	13W
SW COR, NW 1/4 NW 1/4 SE 1/4	7	89N	13W