

Index Legend

County:	Black Hawk
Section(s):	07 Township: 88 N Range: 13 W
Corner(s):	East 1/4 Corner
Requestor:	City of Waterloo
Proprietor:	City of Waterloo
Surveyor:	William W. Castle
Surveyor Company:	City of Waterloo Engineering Department 715 Mulberry Street, Waterloo, IA 50703
Return To:	715 Mulberry St, Waterloo, IA 50703 291-4312



Doc ID: 011869030001 Type: GEN  
Recorded: 11/21/2022 at 03:08:48 PM  
Fee Amt: \$7.00 Page 1 of 1  
Black Hawk County Iowa  
SANDIE L. SMITH RECORDER

File 2023-00008114



United States Public Land Survey Corner Certificate

Land Survey Monument situated in Section 07, Township 88 North, Range 13 West, of the Fifth Principal Meridian, Black Hawk County, Iowa.  
Previously recorded in Misc. Book 295 Page 124 in the Black Hawk County Recorder's Office.

Reason for preparing this certificate, the evidence and detailed procedures used in establishing the corner position, and monumentation found or placed.  
Pavement overlain as part of the City of Waterloo's FY2021 Asphalt Overlay Program, Contract No. 1022. Prior to construction, found 3" disc in concrete pavement 0.4 feet east of centerline joint. Disc and concrete reference monuments installed as part of the Hoff Road Reconstruction (West 4th Street to West Shaulis Road), Iowa DOT Project IX-6585(4)--79-07, City Contract No. 314. Tie for existing monument on road plan sheet 14 indicates disc replaced 1/2" iron pin at same location. Current tie on file does not refer to these concrete reference monuments. After construction, placed a 3-inch survey nail in HMA at the corner using project controls.

PLAN VIEW

Show a minimum of three reference ties to durable physical objects, relevant monuments and physical conditions that will enable recovery of the corner.

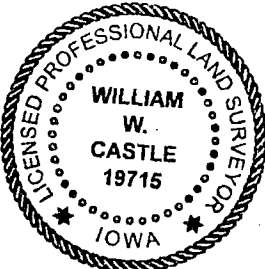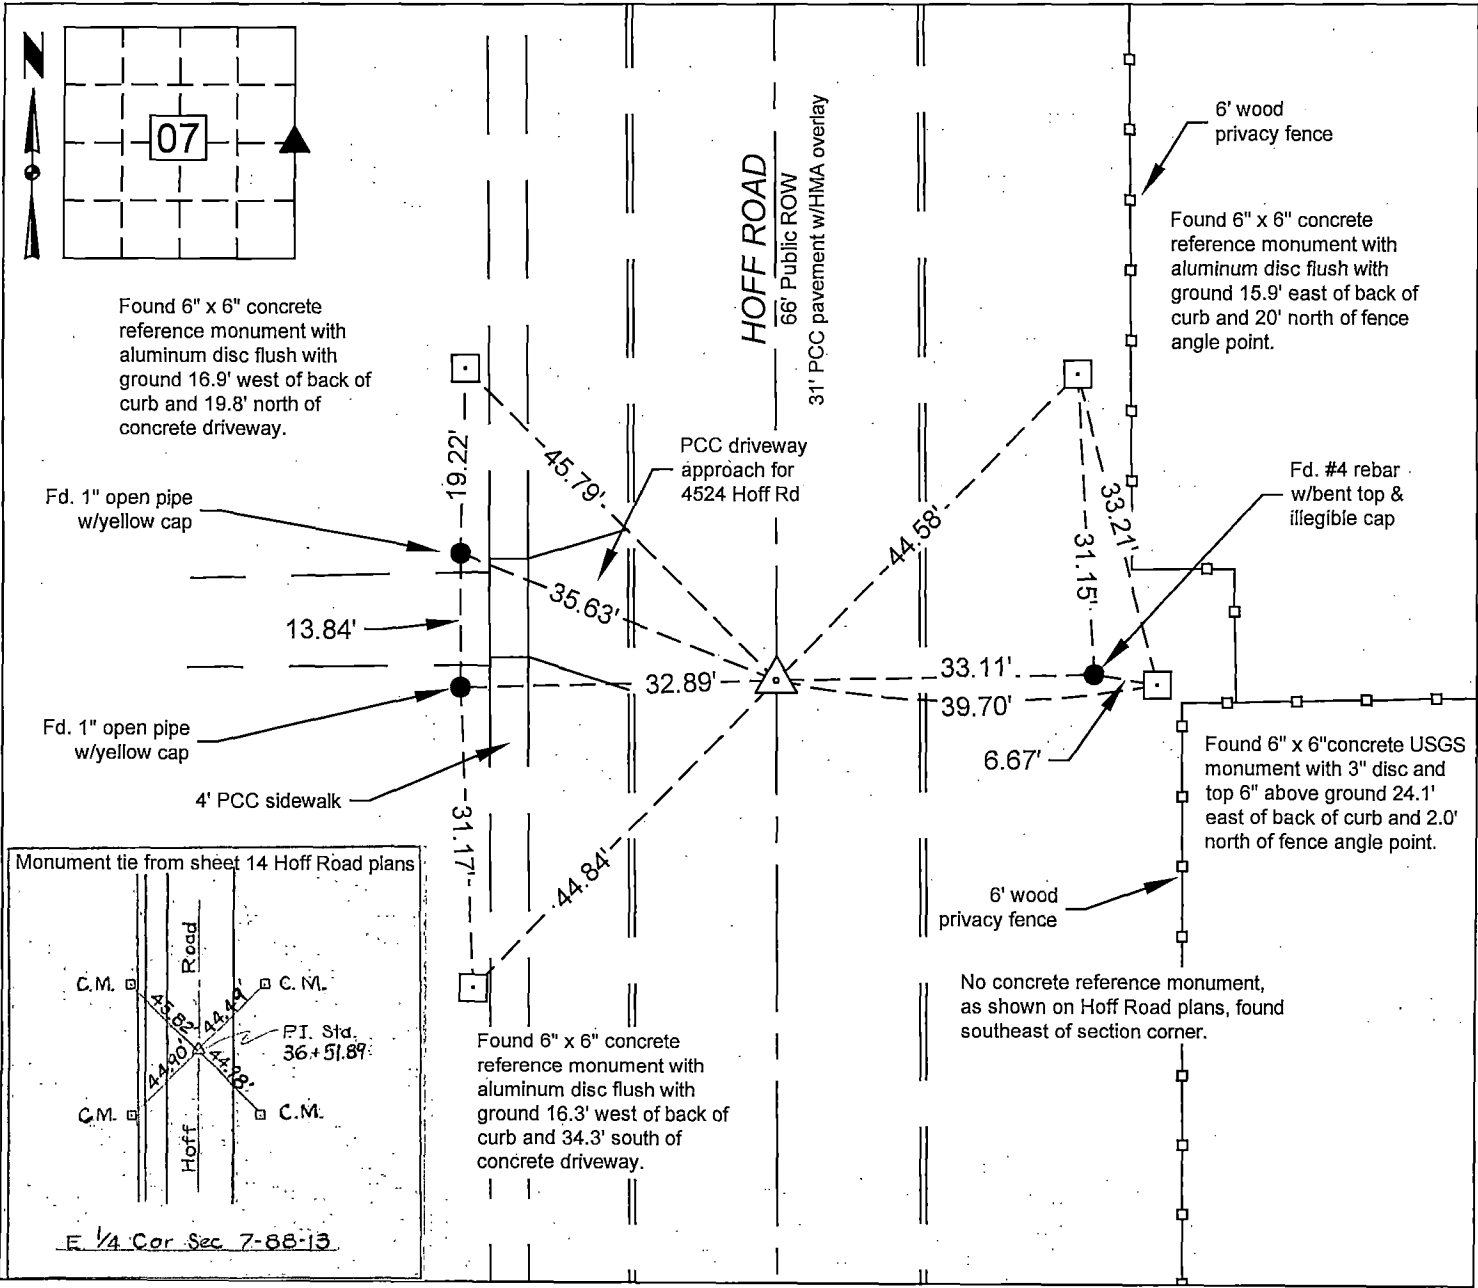

I hereby certify that this surveying document was prepared and the related survey work was performed by me or under my direct personal supervision and that I am a duly licensed Land Surveyor under the laws of the State of Iowa.

*William W. Castle* 11/17/2022  
William W. Castle, PLS Date  
License Number 19715  
My License Renewal Date is December 31, 2023.  
Pages or sheets covered by this seal: 1/1

List corners to be indexed			
Corners	Section	Twp	Range
E 1/4	07	88	13

City of Waterloo Engineering Department  
715 Mulberry Street, Waterloo, Iowa 50703  
Phone: (319) 291-4312 Fax: (319) 291-4262

Drawn By: WWC Scale: 1" = 20'  
Field Work Date: 7-1-2022  
Date Drawn: 11-17-2022

Sheet No.  
1 of 1