

UNITED STATES PUBLIC LAND SURVEY CORNER CERTIFICATE

OF


Land Survey Monuments situated in Section 8, Township 88N, Range 13W, of the Fifth Principal Meridian, BLACK HAWK County, Iowa. Previously recorded in N/A in County Recorder's Office.

(book, page, document number, etc.)
how reason for preparing this certificate, the evidence and detailed procedures used in establishing the corner positions and monumentation found or placed.)

Monument Description and Remarks: FOUND 1/2" ϕ REBAR USING TIES CES OF 1989.
IN 1989 CES FOUND 1/2" ϕ REBAR USING D.O.T. TIES OF 1976 (IA. 520 PROJECT)
BOT DIST. 1976 TO NW COR SEC. 8 = 2652.72'. 1992 CES DIST. TO NW COR
SEC. 8 = 2652.60' EDM.

PLAN - VIEW

(Show a minimum of three reference ties to durable physical objects, relevant monuments and physical conditions that will enable recovery of the corner.)

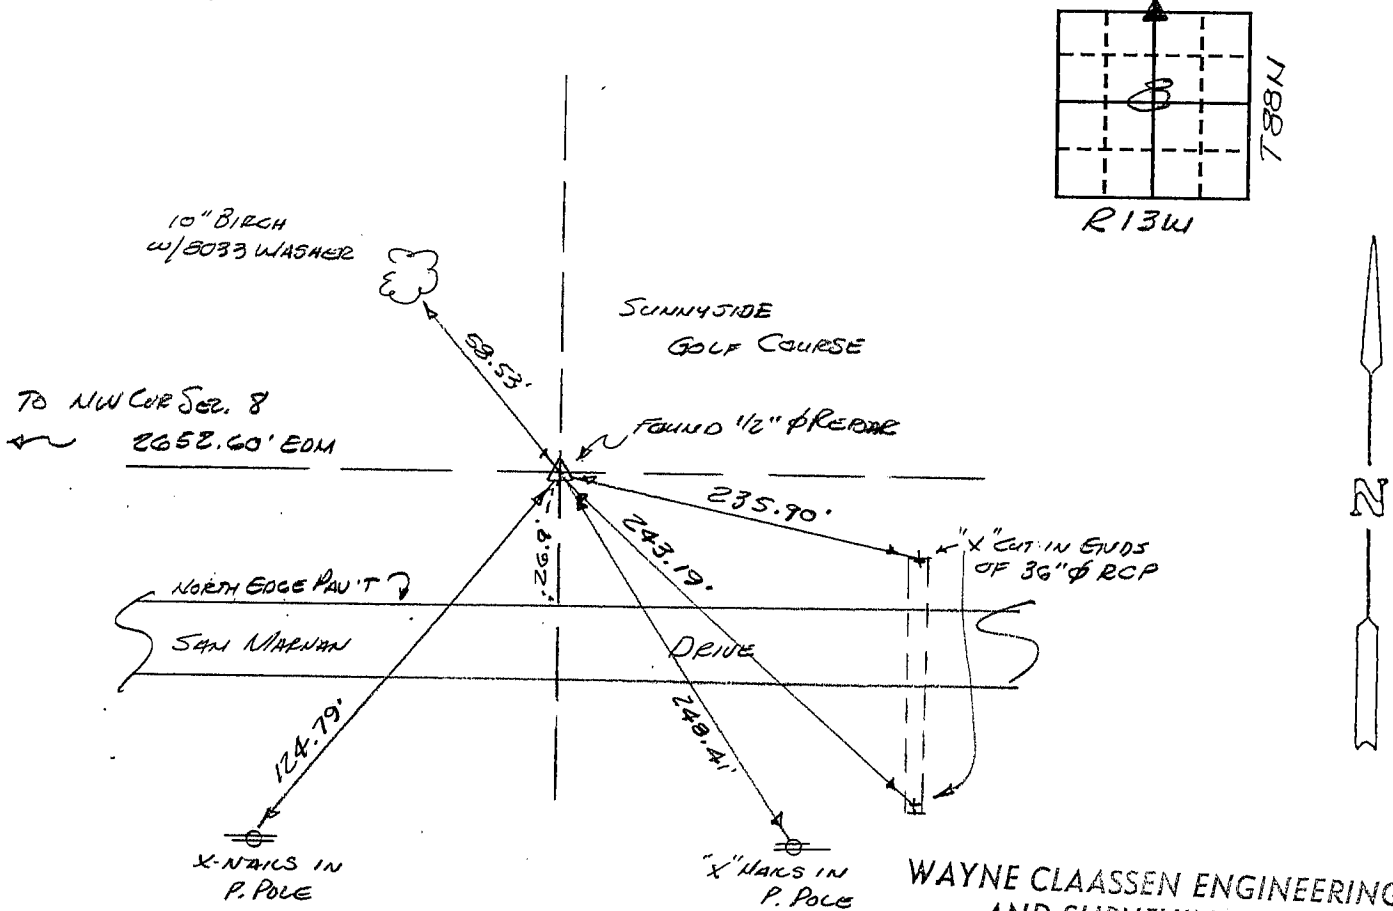

WAYNE CLAASSEN ENGINEERING
AND SURVEYING, INC.
2709 UNIVERSITY AVE.
P.O. BOX 898
WATERLOO, IA 50704

A-Park 5TH P. 69
SUNNYSIDE #9 P. 44 & 54

I hereby certify that the survey work was completed and this certificate was prepared by me or under my direct personal supervision and that I am a duly registered land surveyor under the laws of the state of Iowa.

Signature: F. William King
Name typed or printed: F. WILLIAM KING

Date: 2-3-1993 Reg. No. 8033

Corners	List Corners to be Indexed		
	Section	Twp	Range
<u>N 1/4</u>	<u>8</u>	<u>88N</u>	<u>13W</u>

SEAL



MISC. BK. 305 p. 35