

UNITED STATES PUBLIC LAND SURVEY CORNER CERTIFICATE

OF

Land Survey Monuments situated in Section 8, Township 88N, Range 13W, of the Fifth Principal Meridian, BLACK HAWK County, Iowa.
Previously recorded in N/A in County Recorder's Office.

(book, page, document number, etc.)


Show reason for preparing this certificate, the evidence and detailed procedures used in establishing the corner positions and monumentation found or placed.)

Monument Description and Remarks: FOUND 3" Ø ALUMINUM DISK IN CONCRETE PAVING

MARKED $\frac{5}{8} \frac{4}{9}$

PLAN - VIEW

(Show a minimum of three reference ties to durable physical objects, relevant monuments and physical conditions that will enable recovery of the corner.)

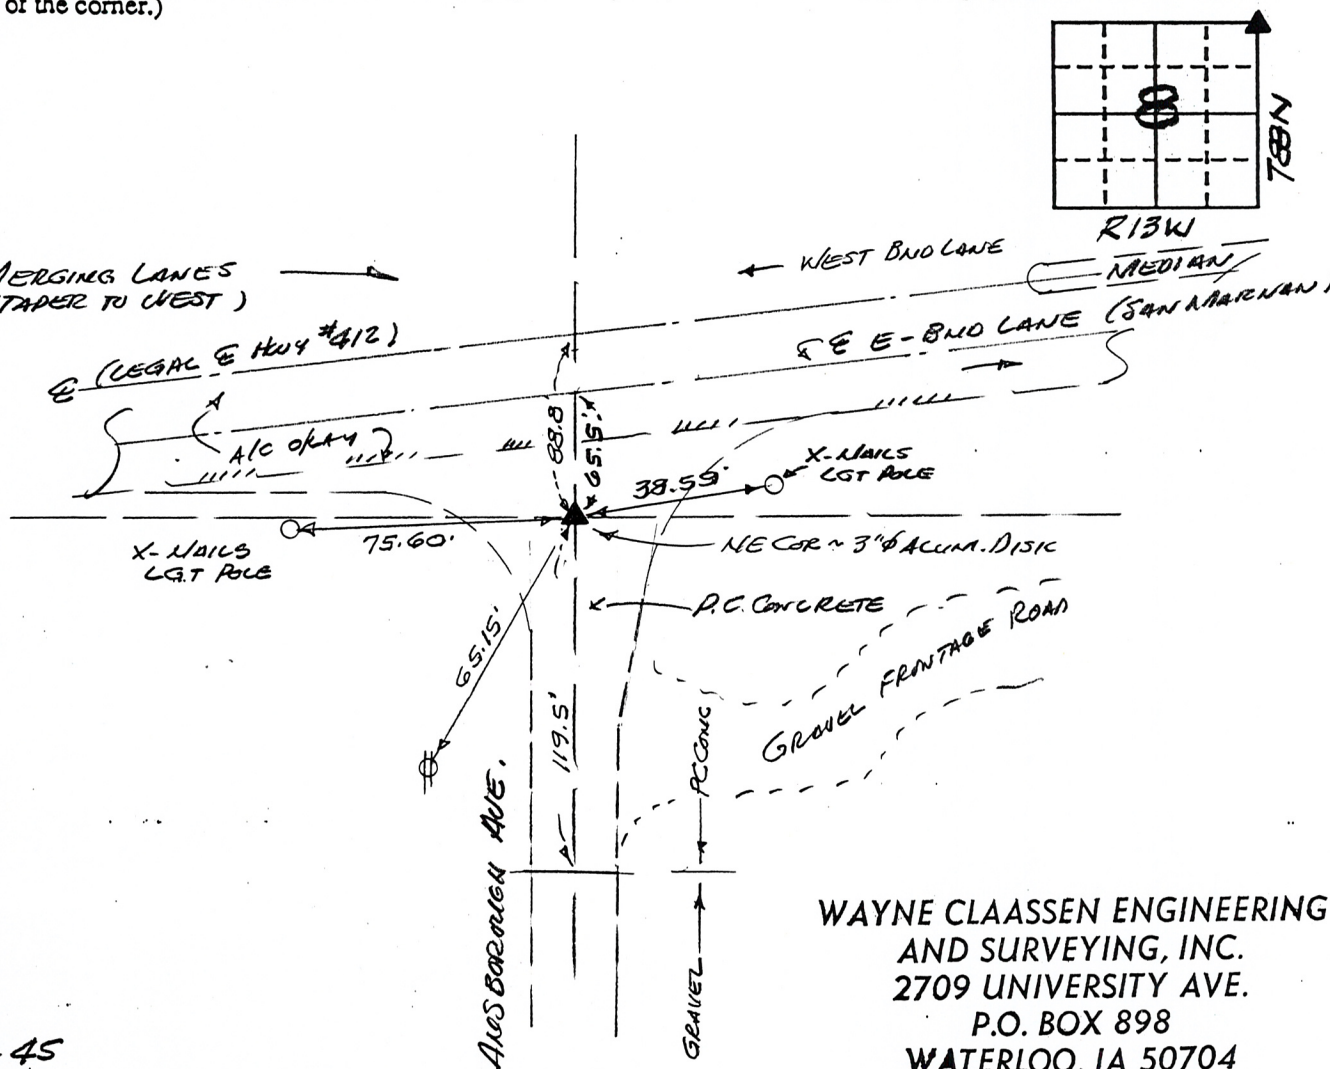

WAYNE CLAASSEN ENGINEERING
AND SURVEYING, INC.
2709 UNIVERSITY AVE.
P.O. BOX 898
WATERLOO, IA 50704

I hereby certify that the survey work was completed and this certificate was prepared by me or under my direct personal supervision and that I am a duly registered land surveyor under the laws of the state of Iowa.

Signature:

Name typed or printed: F. WILLIAM KINGDate: 4-21-1995 Reg. No. 8033

Corners	Section	Twp	Range
NE	8	88N	13W

SEE update, per
PLS 10898 (INDOT)
Fee BK 2008-018973
AS N.W. COR 9-88-13

MISC. BK. 315 p. 418

SEAL

