



Doc ID: 004526650001 Type: GEN
Kind: CORNER
Recorded: 07/21/2011 at 03:55:01 PM
Fee Amt: \$7.00 Page 1 of 1
Black Hawk County Iowa
JUDITH A MCCARTHY RECORDER

File 2012-00001313✓

UNITED STATES PUBLIC LAND SURVEY CORNER CERTIFICATE
OF


Land Survey Monuments situated in Section 09, Township 88 N, Range 13 W, of the Fifth Principal Meridian, Black Hawk County, Iowa
Previously recorded in Book N/A, Page .

Show reason for preparing this certificate, the evidence and detailed procedures used in establishing the corner positions and monumentation found or placed.)

Monument Description and Remarks: N 1/4 corner 09-88-13
Found concrete monument with aluminum cap at location prior to construction of Hurst Drive. Set 5/8" ø X 24" rebar with 1 1/2" ø aluminum cap # 12088 at location after construction. Corner was used for Tower Park No. 5 subdivision. No previous corner certificates on file.

PLAN - VIEW

(Show a minimum of three reference ties to durable physical objects, relevant monuments and physical conditions recovery of the corner.)

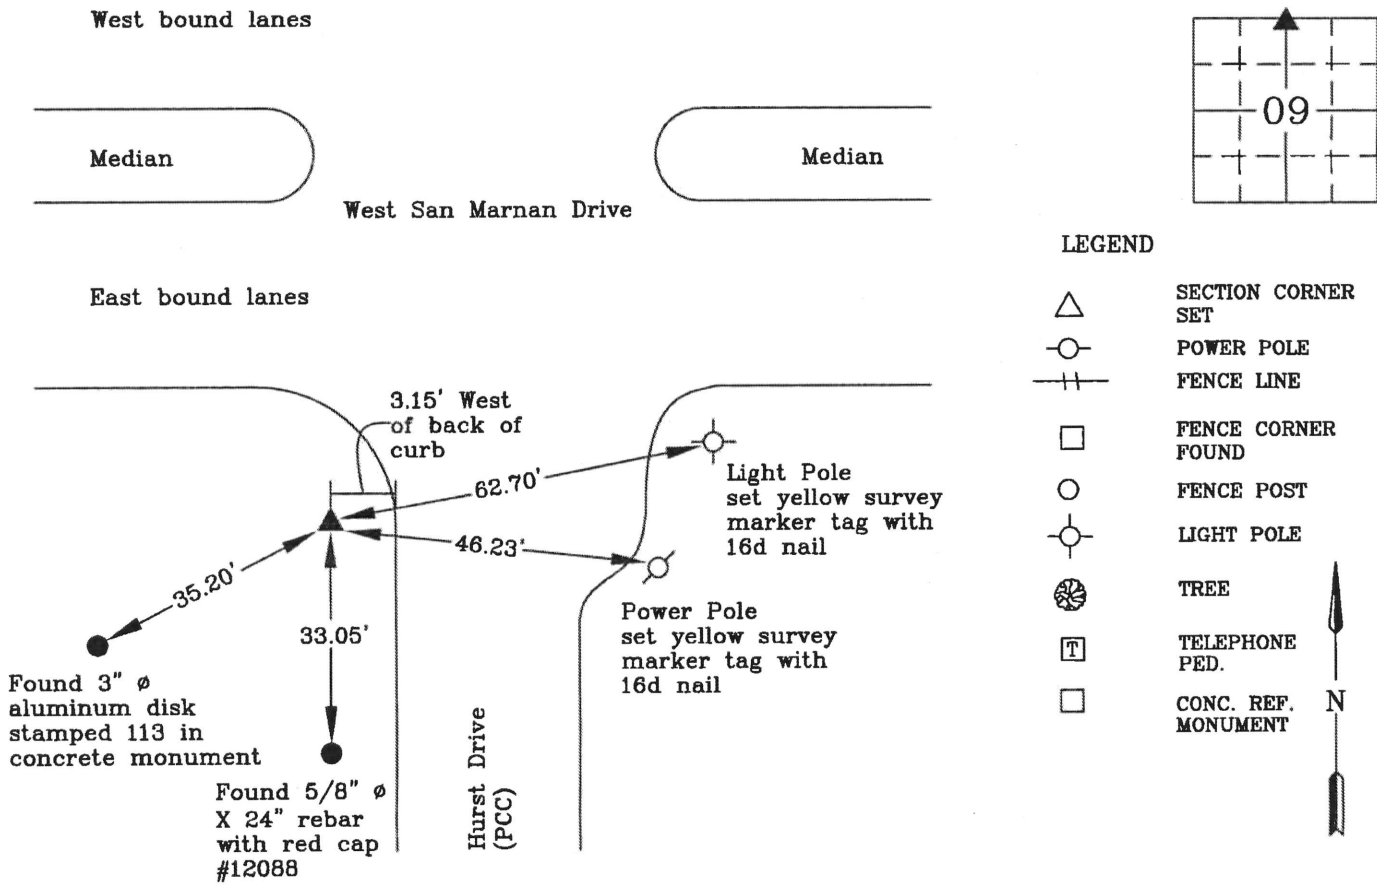

I hereby certify that this land surveying document was prepared and the related survey work was performed by me or under my direct personal supervision and that I am a duly licensed Land Surveyor under the laws of the State of Iowa.



Wendell J. Lupkes 7-12-11
WENDELL J. LUPKES, L.S. DATE
License number 12088
My license renewal date is December 31, 2012
Pages or sheets covered by this seal: 1

List Corner to be Indexed

Corner	Section	Twp	Range
N 1/4 Cor.	09	88 N	13 W



* VJ Engineering
1501 Technology Parkway
Cedar Falls, Iowa - 319-266-5829

SECTION CORNER
REFERENCE TIES

scale
NONE
drawn by
JAL
date
7/8/11