



Doc ID: 012065070001 Type: GEN
Recorded: 01/26/2024 at 09:26:58 AM
Fee Amt: \$7.00 Page 1 of 1
Black Hawk County Iowa
SANDIE L. SMITH RECORDER

File **2024-00009352**

Michael R. Fagle, P.L.S. AECOM, 501 Sycamore St., Suite 222, Waterloo, Iowa 50703 I-319-232-6531

UNITED STATES PUBLIC LAND SURVEY CORNER CERTIFICATE
OF


Land Survey Monuments situated in Section 09, Township 88 North,
Range 13 West, of the Fifth Principal Meridian, Black Hawk
County, Iowa. Previously recorded in Document Number 2012-00001313
in County Recorder's Office. (Book, Page, Document Number, etc.)

(Show reason for preparing this certificate, the evidence and detailed procedures used in establishing the corner positions and monumentation found or placed.)

Monument Description and Remarks: Found 5/8" X 24" rebar with 1 1/2" aluminum cap # 12088 from some of the existing ties.

PLAN - VIEW

(Show a minimum of three reference ties to durable physical objects, relevant monuments and physical conditions that will enable recovery of the corner.)

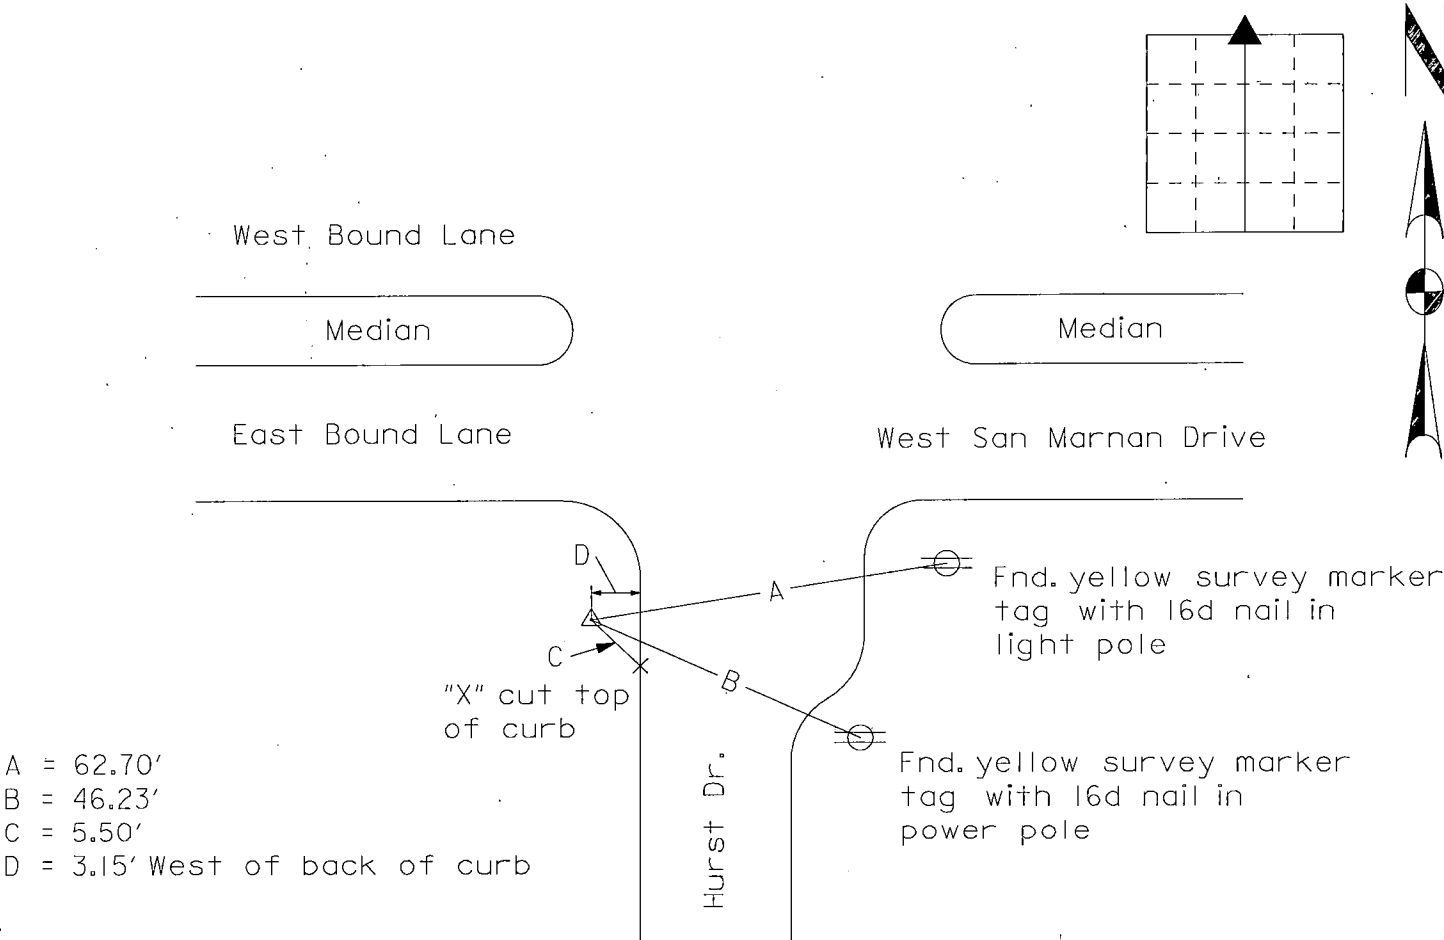

- A = 62.70'
- B = 46.23'
- C = 5.50'
- D = 3.15' West of back of curb

	<p>I hereby certify that this Land Surveying document was prepared by me or under my direct personal supervision and that I am a duly Licensed Land Surveyor under the laws of the State of Iowa.</p> <p><i>Michael R. Fagle</i> 4-21-2023 MICHAEL R. FAGLE Date</p> <p>License number 8505</p> <p>My license renewal date is December 31, 2024</p> <p>Pages or sheets covered by this seal: <u>THIS SHEET</u></p>	<p>List Corners to be Indexed</p> <table><thead><tr><th>Corners</th><th>Section</th><th>Twp</th><th>Range</th></tr></thead><tbody><tr><td>North Corner</td><td>09</td><td>88 N</td><td>13 W</td></tr>
