

IOWA DEPARTMENT OF TRANSPORTATION
1420 4TH ST SE
MASON CITY, IA 50401

I *W*
P *gm*
Z

Document Number: 2008018973
Date: Mar 31, 2008 4:30:00 pm
Aud Fee: 0.00 Rec Fee: 5.00
Trans Tax: 0.00 Rec Management Fee: 1.00
E-Com Fee: 1.00 Non-Standard Page Fee: 0.00
Filed for record in Black Hawk County, Iowa
Judith A. McCarthy, County Recorder

PREPARED BY/ RETURN TO: KENNETH D. STARK IOWA DEPARTMENT OF TRANSPORTATION 1420 4th ST. SE MASON CITY, IA 50401 641-423-7584

UNITED STATES PUBLIC LAND SURVEY CORNER CERTIFICATE
OF

Land Survey Monuments situated in Section 09, Township 88N, Range 13W
of the Fifth Principal Meridian, BLACK HAWK County, Iowa.

Previously recorded in NA in County Recorder's Office.
(book, page, document number, etc.)



(Show reason for preparing this certificate, the evidence and detailed procedures used in establishing the corner positions and monumentation found or placed.)

Monument Description and Remarks:

NW CORNER	Set 1" Brass disk Sec. Cor. *10898 from IDOT information of record after previous monument was obliterated during Ansborough Ave. reconstruction.

PLAN - VIEW

(Show a minimum of three reference ties to durable physical objects, relevant monuments and physical conditions that will enable recovery of the corner.)

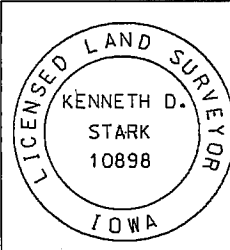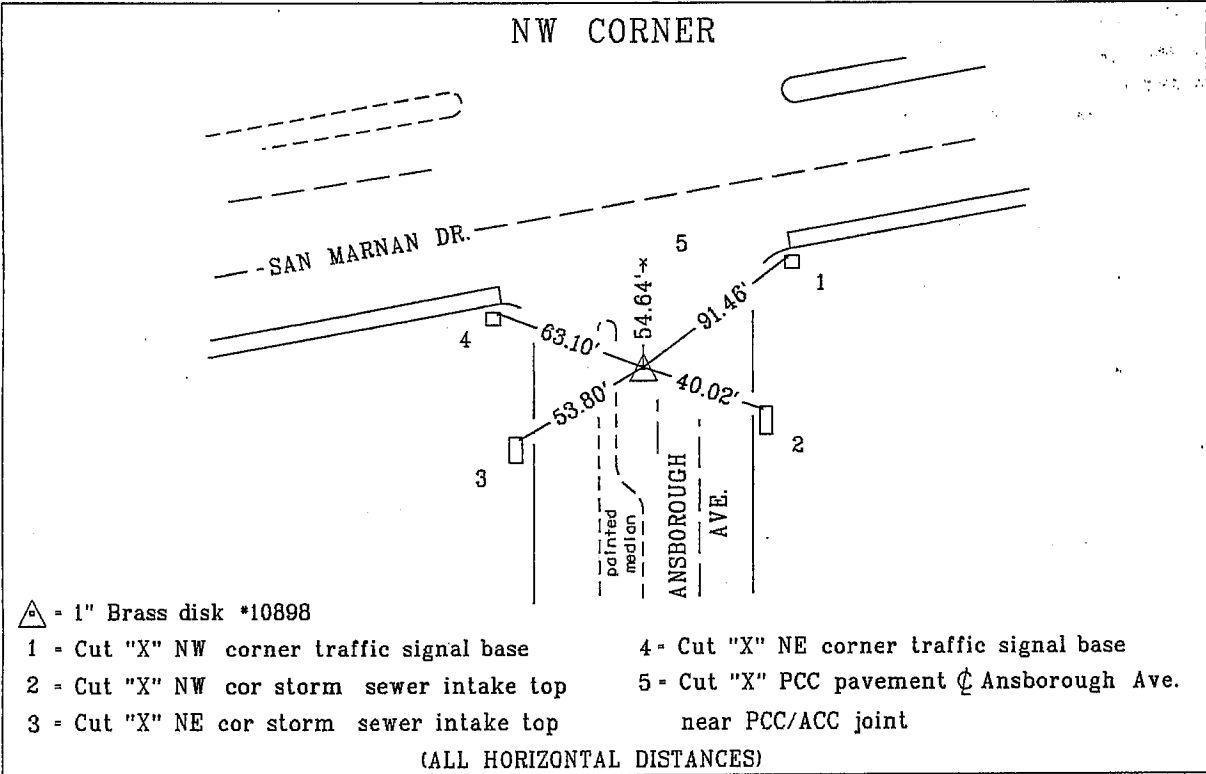

I hereby certify that this land surveying document was prepared and the related survey work was performed by me or under my personal supervision and that I am a duly licensed Land Surveyor under the laws of the state of Iowa.
Kenneth D. Stark 03-27-08
Kenneth D. Stark Date
License number 10898
My License renewal date is December 31, 2009
Pages or sheets covered by this seal. 1

List Corners to be Indexed			
Corner	Section	Township	Range
NW CORNER	09	88N	13W

GIS 2/07
right-of-way
dim