



Doc ID: 012065060001 Type: GEN  
Recorded: 01/26/2024 at 09:26:18 AM  
Fee Amt: \$7.00 Page 1 of 1  
Black Hawk County Iowa  
SANDIE L. SMITH RECORDER

File **2024-00009351**

*X* Michael R. Fagle, P.L.S.                      AECOM, 501 Sycamore St., Suite 222, Waterloo, Iowa 50703                      I-319-232-6531



UNITED STATES PUBLIC LAND SURVEY CORNER CERTIFICATE  
OF

Land Survey Monuments situated in Section 09, Township 88 North,  
Range 13 West, of the Fifth Principal Meridian, Black Hawk  
County, Iowa. Previously recorded in Document Number 2008018973  
in County Recorder's Office. (Book, Page, Document Number, etc.)

(Show reason for preparing this certificate, the evidence and detailed procedures used in establishing the corner positions and monumentation found or placed.)

Monument Description and Remarks: Found 1" Brass Disk stamped # 10898  
\_\_\_\_\_  
\_\_\_\_\_  
\_\_\_\_\_

PLAN - VIEW

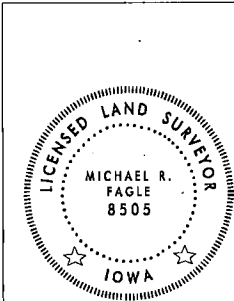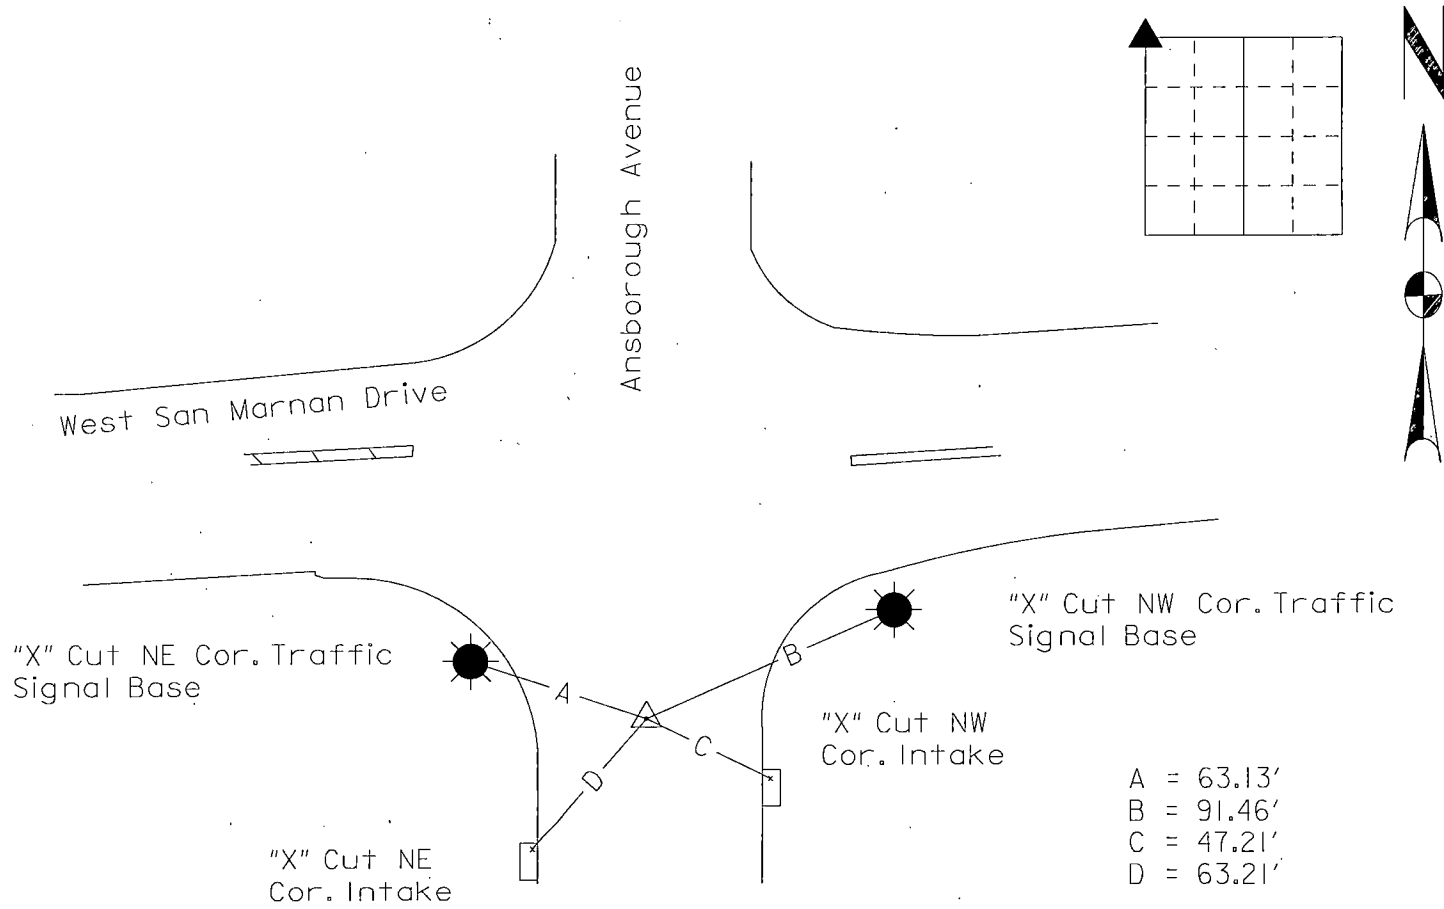

I hereby certify that this Land Surveying document was prepared by me or under my direct personal supervision and that I am a duly Licensed Land Surveyor under the laws of the State of Iowa.

*Michael R. Fagle*                      4-21-2023  
MICHAEL R. FAGLE                      Date

License number 8505

My license renewal date is December 31, 2024

Pages or sheets covered by this seal:  
THIS SHEET

List Corners to be Indexed			
Corners	Section	Twp	Range
Northwest Corner	09	88 N	13 W