

2024-15665
RECORDED: 06/12/2024 01:34:06 PM
RECORDING FEE: \$7.00
REVENUE TAX: \$
COMBINED FEE: \$7.00
SANDIE L. SMITH, RECORDER
BLACK HAWK COUNTY, IOWA


Michael R Fagle, P.L.S. AECOM, 501 Sycamore St, Suite 222, Waterloo, Iowa 50703 I-319-232-6531


UNITED STATES PUBLIC LAND SURVEY CORNER CERTIFICATE
(Correction Document 2024-00009350) OF
Land Survey Monuments situated in Section 09, Township 88 North, Range 13 West, of the Fifth Principal Meridian, Black Hawk County, Iowa. Previously recorded in Document Number 2016-00009569 in County Recorder's Office. (Book, Page, Document Number, etc.)

(Show reason for preparing this certificate, the evidence and detailed procedures used in establishing the corner positions and monumentation found or placed.)

Monument Description and Remarks: Found Cut "X" from previous ties.
Re-cut the found "X"

PLAN - VIEW

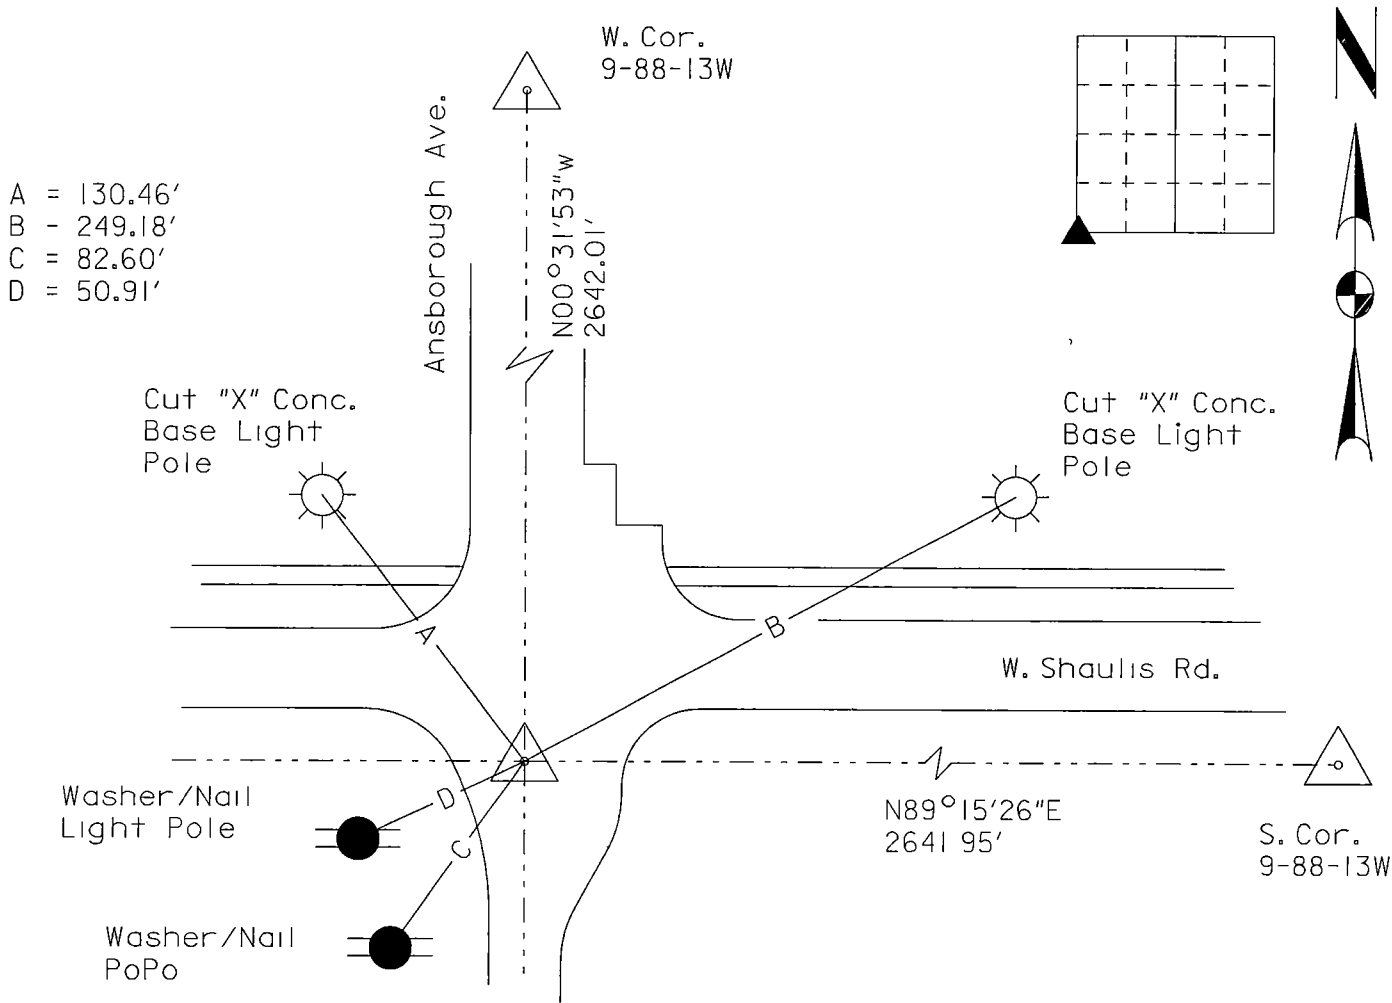
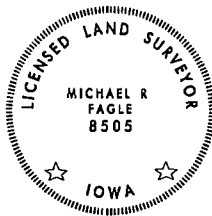
<div><p>I hereby certify that this Land Surveying document was prepared by me or under my direct personal supervision and that I am a duly Licensed Land Surveyor under the laws of the State of Iowa</p><p><i>Michael R Fagle</i> 6-12-2024 MICHAEL R FAGLE Date License number 8505 My license renewal date is December 31, 2024 Pages or sheets covered by this seal THIS SHEET</p></div>	<table><tr><th colspan="4">List Corners to be Indexed</th></tr><tr><th>Corners</th><th>Section</th><th>Twp</th><th>Range</th></tr><tr><td>Southwest Corner</td><td>09</td><td>88 N</td><td>13 W</td></tr></table>	List Corners to be Indexed				Corners	Section	Twp	Range	Southwest Corner	09	88 N	13 W
List Corners to be Indexed													
Corners	Section	Twp	Range										
Southwest Corner	09	88 N	13 W										