

Michael R. Fagle, P.L.S.

AECOM, 501 Sycamore St., Suite 222, Waterloo, Iowa 50703

I-319-232-6531


UNITED STATES PUBLIC LAND SURVEY CORNER CERTIFICATE
OF

Land Survey Monuments situated in Section 09, Township 88 North,
Range 13 West, of the Fifth Principal Meridian, Black Hawk
County, Iowa. Previously recorded in Document Number 2010-00017075
in County Recorder's Office. (Book, Page, Document Number, etc.)

(Show reason for preparing this certificate, the evidence and detailed procedures
used in establishing the corner positions and monumentation found or placed.)

Monument Description and Remarks: Found Cut "X" from previous ties

PLAN - VIEW

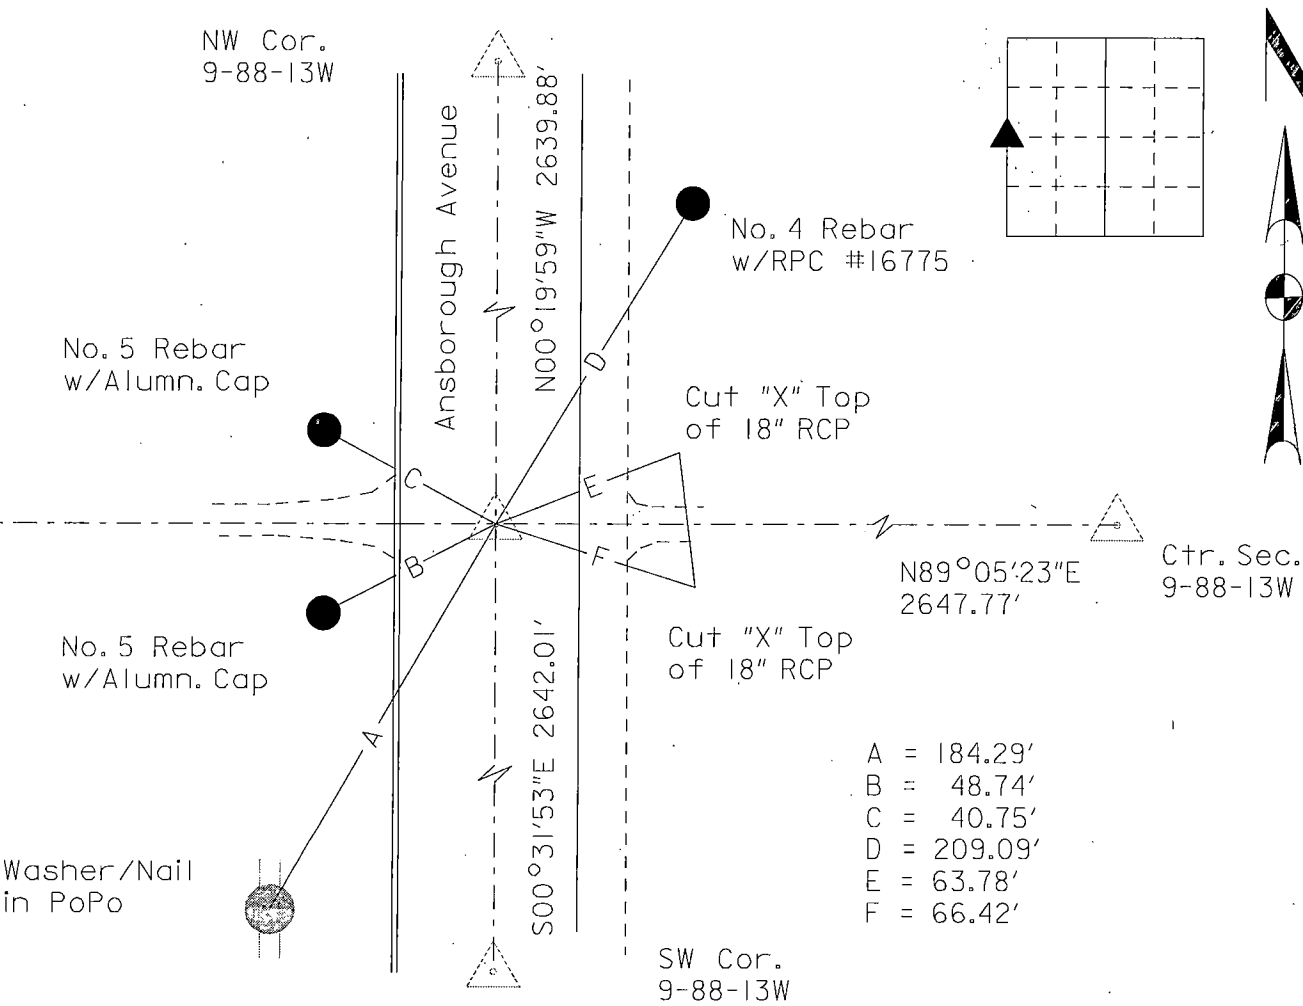

LICENSED LAND SURVEYOR MICHAEL R. FAGLE 8505 IOWA I hereby certify that this Land Surveying document was prepared by me or under my direct personal supervision and that I am a duly Licensed Land Surveyor under the laws of the State of Iowa. <i>Michael R. Fagle</i> 4-21-2023 MICHAEL R. FAGLE Date License number 8505 My license renewal date is December 31, 2024 Pages or sheets covered by this seal: <u>THIS SHEET</u>	List Corners to be Indexed <table><tr><th>Corners</th><th>Section</th><th>Twp</th><th>Range</th></tr><tr><td>West Corner</td><td>09</td><td>88 N</td><td>13 W</td></tr></table>	Corners	Section	Twp	Range	West Corner	09	88 N	13 W
Corners	Section	Twp	Range						
West Corner	09	88 N	13 W						