

POOR COPY
OF FORM

SLSI 9-94

UNITED STATES PUBLIC LAND SURVEY CORNER CERTIFICATE

OF

Land Survey Monuments situated in Section 11, Township 88 N, Range 13 W, of the Fifth Principal Meridian, BLACK HAWK County, Iowa. Previously recorded in _____ in County Recorder's Office.


(book, page, document number, etc.)

(Show reason for preparing this certificate, the evidence and detailed procedures used in establishing the corner positions and monumentation found or placed.)

Monument Description and Remarks: SEE BELOW FOR DESCRIPTIONS.

PLAN - VIEW

(Show a minimum of three reference ties to durable physical objects, relevant monuments and physical conditions that will enable recovery of the corner.)

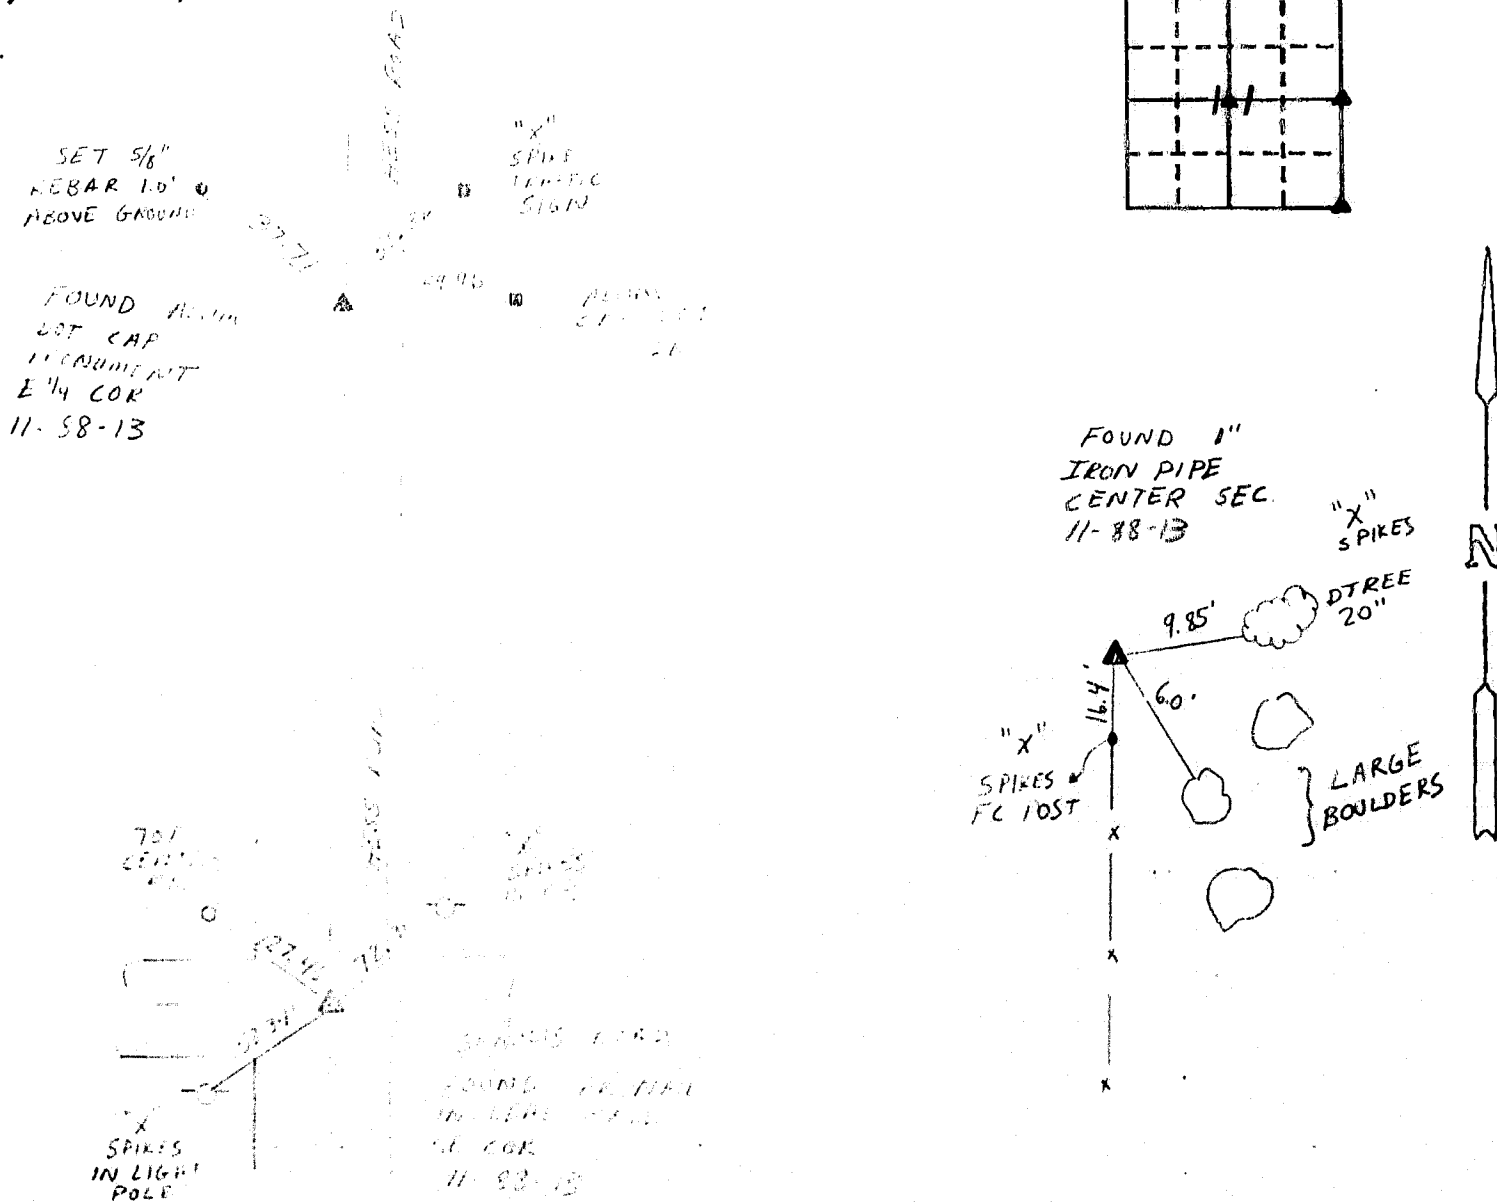

I hereby certify that the survey work was completed and this land surveying document was prepared by me or under my direct personal supervision and that I am a duly registered land surveyor under the laws of the state of Iowa


Signature: Myron Schabo

Name typed or printed: Myron Schabo

Date: 10-11-48 Reg. No. 8807

My registration renewal date is December 31, 1949

SEAL

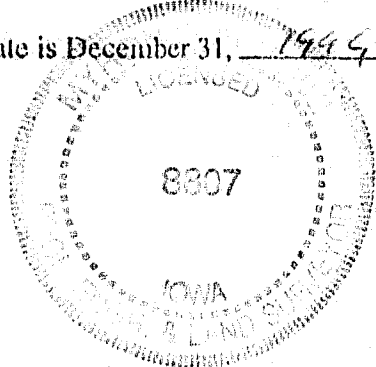

List Corners to be Indexed			
Corners	Section	Twp	Range
SE COR	11	88 N	13 W
E 1/4 COR	11	88 N	13 W
CENTER	11	88 N	13 W