

MISC, SC  
INDEX VS  
MARGIN  
PROOF ON  
COMPARE

BLACK HAWK COUNTY IOWA:SS 9369  
Filed for record OCT 22, 1999 at  
3:00 PM. and recorded in Book 336  
of MISCELLANEOUS Page 134.

*Wayne Claassen* Recorder  
FEE 1-5.00/  
WAYNE CLAASSEN ENGINEERING & SURVEYING INC

RECEIVED - BLACK HAWK CO. ASSESSOR

WAYNE CLAASSEN ENGINEERING AND SURVEYING, INC.  
P.O. BOX 898 WATERLOO, IOWA 50704-0898

PHONE: (VOICE) 319-235-6294  
(FAX) 319-235-0028

## UNITED STATES PUBLIC LAND SURVEY CORNER CERTIFICATE


and Survey Monuments situated in Section 12, Township 88N, Range 13W, of the Fifth Principal Meridian, BLACK HAWK County, Iowa.  
Previously recorded in N/A in County Recorder's Office.  
(book, page, document number, etc.)

Show reason for preparing this certificate, the evidence and detailed procedures used in establishing the corner positions and monumentation found or placed.)

Monument Description and Remarks South 1/4 corner, found lead plug with X cut in concrete paving.

### PLAN - VIEW

Show a minimum of three reference ties to durable physical objects, relevant monuments and physical conditions that will enable recovery of the corner.)

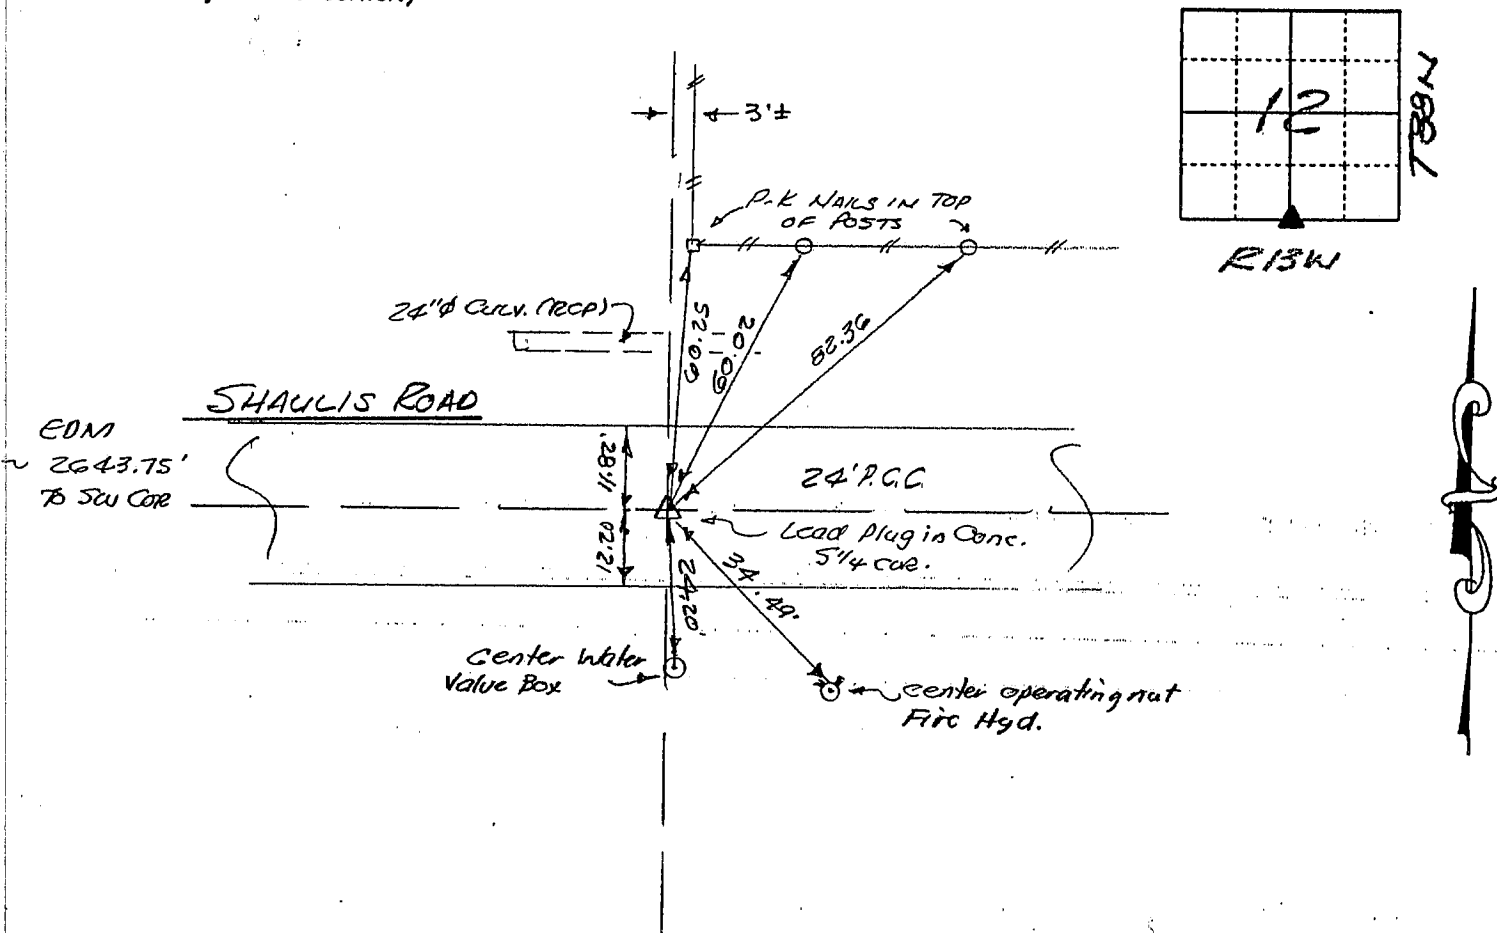


490-37

I hereby certify that the survey work was completed and this certificate was prepared by me or under my direct personal supervision and that I am a duly licensed land surveyor under the laws of the state of Iowa.

Signature: *F. William King*  
(Name typed or printed:) F. WILLIAM KING  
Date: OCT. 20, 1999 Lic. No. 8033

REAL

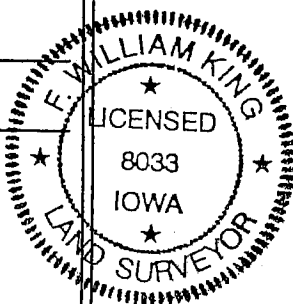

List Corners to be Indexed

| Corners | Section | Twp | Range |
|---------|---------|-----|-------|
| S 1/4   | 12      | 88N | 13W   |

BOOK 336 PAGE 134