



Doc ID: 004702450001 Type: GEN Kind: CORNER Recorded: 02/03/2012 at 03:26:07 PM Fee Amt: \$7.00 Page 1 of 1 Black Hawk County Iowa JUDITH A MCCARTHY RECORDER File 2012-00014403

## UNITED STATES PUBLIC LAND SURVEY CORNER CERTIFICATE

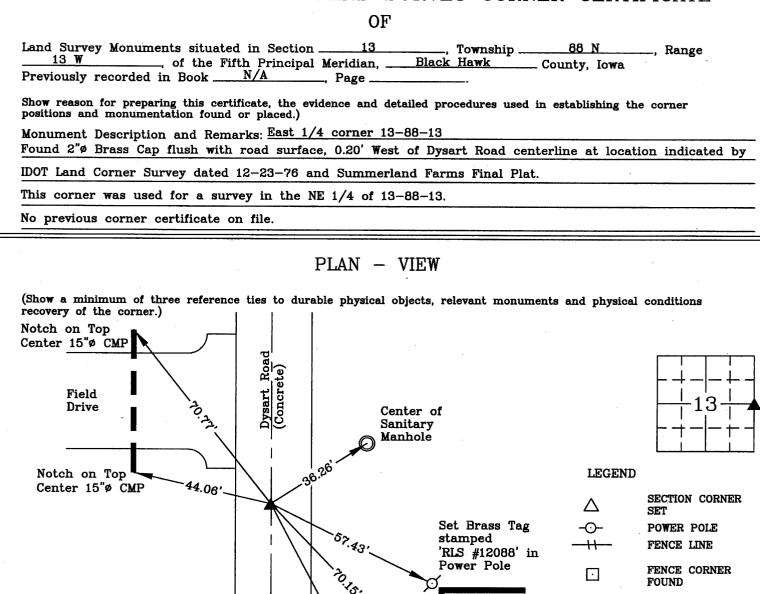

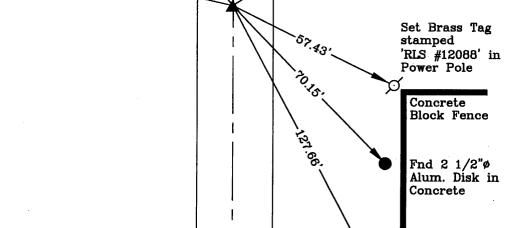

Set Brass Tag

0 FENCE POST LIGHT POLE

TREE TELEPHONE PED. CONC. REF. MONUMENT

stamped 'RLS #12088' in Power Pole I hereby certify that this land surveying document was prepared and the related survey work was performed by me or under my direct personal supervision and that I am a duly licensed Land Surveyor under the laws of the State of Iowa.



WENDELL 1/ LUPKES, L.S.

License number 12088 My license renewal date is December 31, 2012 Pages or sheets covered by this seal: \_

List Corner to be Indexed

Corner Section Twp Range E 1/4 Cor. 13 88 N 13 W

T

 $\Box$ 



VJ Engineering 1501 Technology Parkway Cedar Falls, Iowa - 319-266-5829

SECTION CORNER REFERENCE TIES

scale drawn by

date