

WAYNE CLAASSEN ENGINEERING AND SURVEYING INC

WAYNE CLAASSEN ENGINEERING AND SURVEYING, INC.  
P.O. BOX 898 WATERLOO, IOWA 50704-0898

PHONE: (VOICE) 319-235-6294  
(FAX) 319-235-0028

## UNITED STATES PUBLIC LAND SURVEY CORNER CERTIFICATE


Land Survey Monuments situated in Section 13, Township 88N, Range 13W, of the Fifth Principal Meridian, Black Hawk County, Iowa.  
Previously recorded in N/A in County Recorder's Office.  
(book, page, document number, etc.)

(Show reason for preparing this certificate, the evidence and detailed procedures used in establishing the corner positions and monumentation found or placed.)

Monument Description and Remarks West 1/4 Corner, found cap pin No. 8505  
per ties from Earth Tech Engineering.

### PLAN - VIEW

(Show a minimum of three reference ties to durable physical objects, relevant monuments and physical conditions that will enable recovery of the corner.)

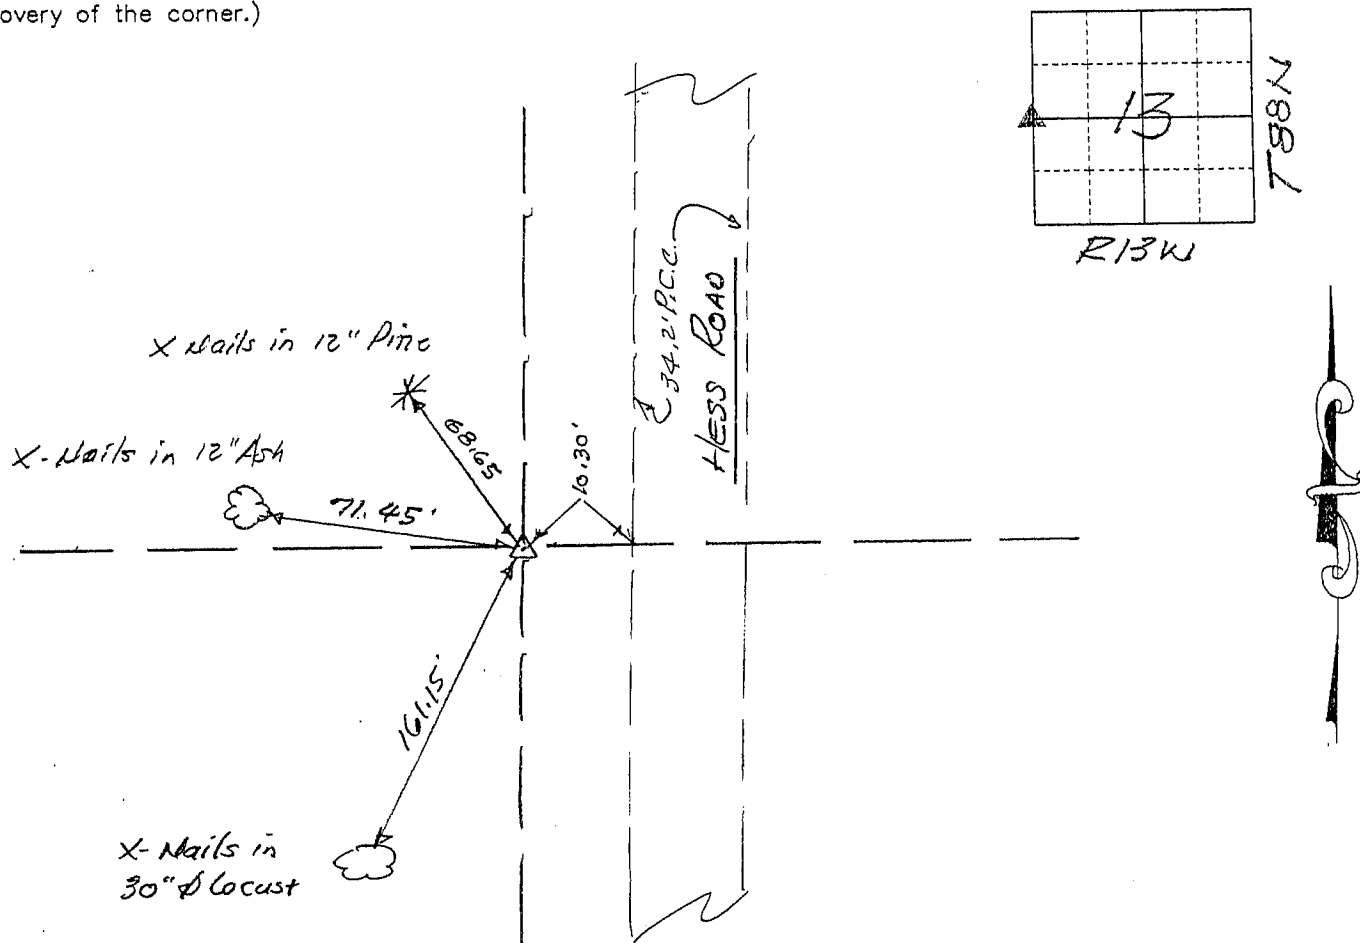

551-34

I hereby certify that the survey work was completed and this certificate was prepared by me or under my direct personal supervision and that I am a duly licensed land surveyor under the laws of the state of Iowa.

Signature: F. William King

(Name typed or printed:) F. William King

Date: May 5, 2003

Lic. No. 8033

SEAL

#### List Corners to be Indexed

Corners	Section	Twp	Range
<u>W 1/4</u>	<u>13</u>	<u>88N</u>	<u>13W</u>

