

WAYNE CLAASSEN ENGINEERING AND SURVEYING, INC.  
P.O. BOX 898    WATERLOO, IOWA 50704-0898

PHONE: (VOICE) 319-235-6294  
(FAX) 319-235-0028

UNITED STATES PUBLIC LAND SURVEY CORNER CERTIFICATE

Land Survey Monuments situated in Section 13, Township 88 North, Range 13 West, of the Fifth Principal Meridian, Black Hawk County, Iowa.




Previously recorded in \_\_\_\_\_ in County Recorder's Office.  
(book, page, document number, etc.)

Monument Description and Remarks

Set 'X' cut in concrete at midpoint between NW Corner and N 1/4 Corner of this Section.

PLAN - VIEW

- Reason for filing certificate:
- ☒ There is no certificate on file with the Recorder's Office.
  - ☐ Accepts corner position which differs from the one shown in above document.
  - ☐ The corner monument was replaced or modified.
  - ☐ The reference ties in above document were incorrect or missing.

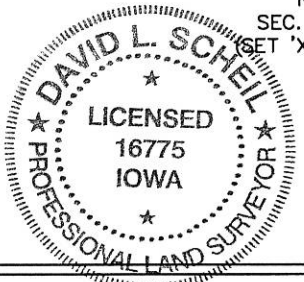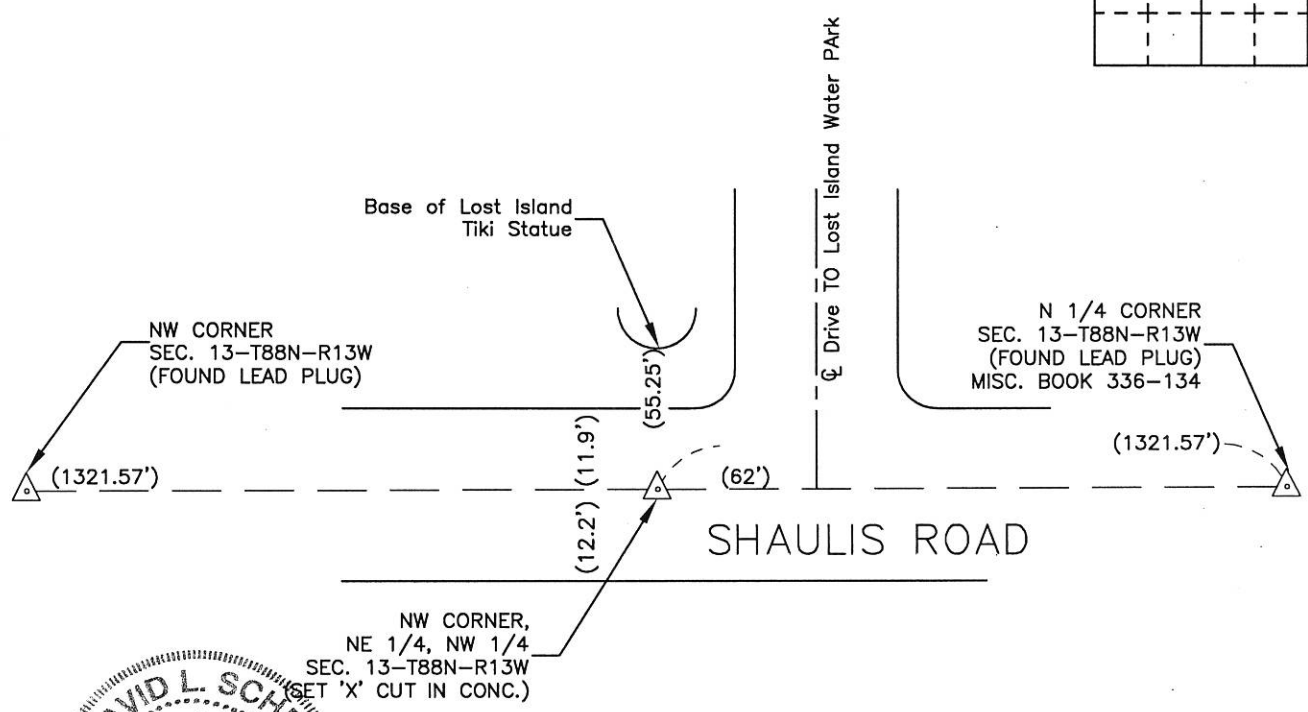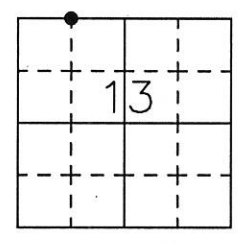

Iowa State Plane Coordinate System  
(North Zone, 2011 Adj.)  
N= 3626745.9  
E= 5241726.0  
(For reference only)

I hereby certify that this land surveying document was prepared and the related survey work was performed by me or under my direct personal supervision and that I am a duly Licensed Land Surveyor under the laws of the State of Iowa.

Signature: David L. Scheil  
David L. Scheil, L.S.

Date: OCT. 10, 2019 Lic. No. 16775

Pages or Sheets Covered by this Seal: THIS SHEET ONLY.

My license renewal date is December 31, 2020

SEAL

List Corners to be Indexed			
Corners	Section	Twp	Range
NW CORNER, NE 1/4, NW 1/4,	13	88 N	13 W
SW CORNER, SE 1/4, SW 1/4,	12	88 N	13 W