

SC ✓
Misc ✓

21244

BLACK HAWK COUNTY IOWA: SS
MAHGIN filed for record May 14, 19 96 at
PROOF 3:30 P.M. and recorded in Book 320
COMPARE of Misc Page 500

Patricia J. Lee
Recorder
Fee 1-5.00x

Taxity Assessor

Michael R. Fagle L.S. - RUST - 501 Sycamore ST. Suite 222 Waterloo, Iowa 50703 - 1-319-232-6531

SLSI 9-90

UNITED STATES PUBLIC LAND SURVEY CORNER CERTIFICATE

OF


Land Survey Monuments situated in Section 15, Township 33 NORTH, Range 13 WEST, of the Fifth Principal Meridian, BLACK HAWK County, Iowa.
Previously recorded in Misc 311 p. 982 in County Recorder's Office.
(book, page, document number, etc.)

(Show reason for preparing this certificate, the evidence and detailed procedures used in establishing the corner positions and monumentation found or placed.)

Monument Description and Remarks: NE CORNER - FOUND IN A FIELD
TIES FROM BLACK HAWK COUNTY ENGINEERING OFFICE

PLAN - VIEW

(Show a minimum of three reference ties to durable physical objects, relevant monuments and physical conditions that will enable recovery of the corner.)

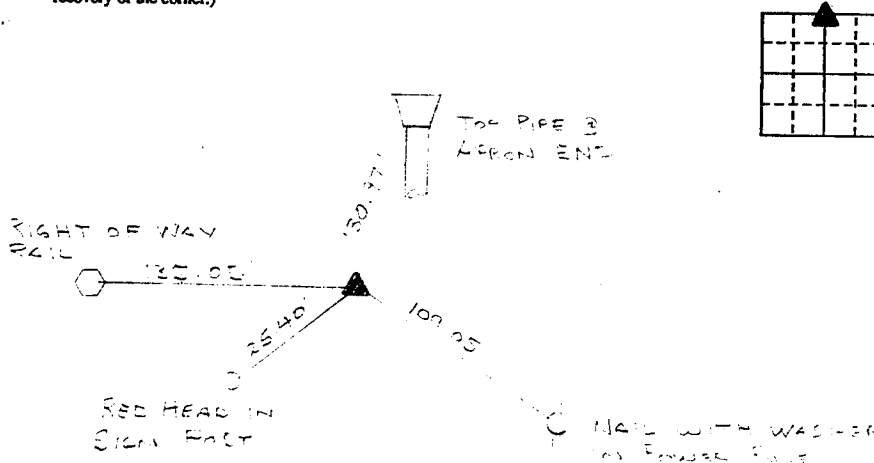


I hereby certify that the survey work was completed and this certificate was prepared by me or under my direct personal supervision and that I am a duly registered land surveyor under the laws of the state of Iowa.

Signature: *Michael R. Fagle*
Name typed or printed: Michael R. Fagle, L.S.

Date: 5-14-96 Reg. No. 8505

My registration renewal date is
December 31, 1996

SEAL

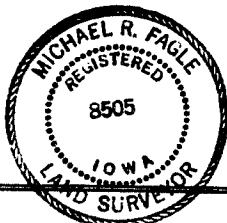

Corners	List Corners to be Indexed Section	Twp	Range
NE	15	33 N	13 W

BOOK 320 PAGE 500