

UNITED STATES PUBLIC LAND SURVEY CORNER CERTIFICATE

SLSI 9-90

OF


Land Survey Monuments situated in Section 17, Township 88N, Range 13W, of the Fifth Principal Meridian, BLACK HAWK County, Iowa.
Previously recorded in N/A in County Recorder's Office.

(Show reason for preparing this certificate, the evidence and detailed procedures used in establishing the corner positions and monumentation found or placed.)

Monument Description and Remarks: FOUND 1/2" Ø REBAR 2" DEEP. THIS CORNER WAS FOUND TO BE A 5CM 17" DEEP BY CLAASSEN ENGINEERING IN 1984. A 1/2" Ø REBAR WAS SET OVER MONUMENT IN 1984.

PLAN - VIEW

(Show a minimum of three reference ties to durable physical objects, relevant monuments and physical conditions that will enable recovery of the corner.)

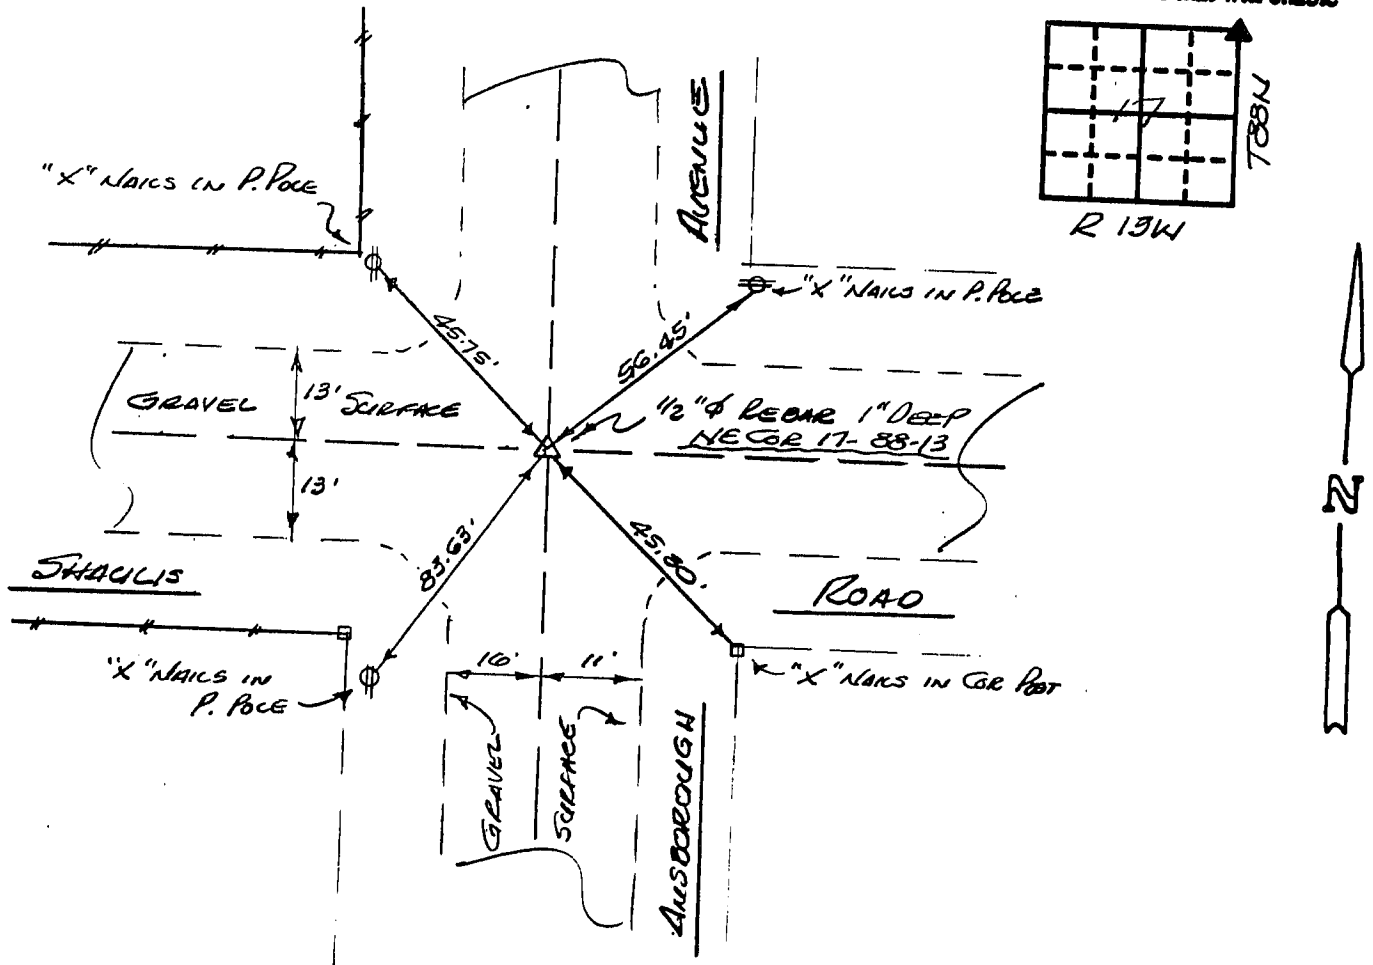

I hereby certify that the survey work was completed and this certificate was prepared by me or under my direct personal supervision and that I am a duly registered land surveyor under the laws of the state of Iowa.

Signature: F. William King
Name typed or printed: F. WILLIAM KING
Date: 3-13-1991 Reg. No. 8033



Corners	List Corners to be Indexed	Section	Twp	Range
NE	17	88N	13W	

MISC. BK. 295 p. 120

SEAL