B.H. Co. PROJECT:

(IA.) PUBLIC LAND SURVEY U.S. CORNER CERTIFICATE (Ia. 355.11)

FM-C007(139)--55-07

KIMBALL AVE. (V27) RESURFACING PROJECT (2016)

COLD IN-PLACE RECYCLING w/ H.M.A. RESURFACING

"Measured" Dimension "NP" = Ref
"Platted" Dimension "MLM" = In

File 2017-00009752

Doc ID: 007214940001 Type: GEN Recorded: 11/21/2016 at 12:39:19 PM Fee Amt: \$0.00 Page 1 of 1 Black Hawk County Iowa SANDIE L. SMITH RECORDER


Land Survey Monument(s) situated in Section 21, Township 88 N., Range 13 W., of the Fifth Principal Meridian (5th P.M.), <u>BLACK HAWK</u> County, Iowa. Previously recorded in MISC. Book <u>311</u>, Page <u>986</u>, in County Recorder's Office. (Show reason for preparing this certificate): The corner monument has been Replaced or Modified, per Ia. Code 355.11(1)(c) (Evidence and detailed procedures used in establishing the corner position(s) and monumentation found or placed.) Monument Description and Remarks: E. 1/4 CDR.:

CORNER RESET & TIES UPDATED PER COLD-IN-PLACE RECYCLING & H.M.A. RESURF. PROJECT

FM-C007(139)--55-07. PRIOR TO RESURF. PROJECT, FOUND #6 (3/4") IRON BAR. PER CURRENT

COR. CERT. & TEMP. REF. COR. LOC. PER RTK GPS. AFTER 3" DP. MILL (RECYCLE), NO SOUNDING

REMAINED @ **ETK REFERENCE LOCATION W/ NO FURTHER EXCAVATION. POWT. RESURFACED W/ +3" (1.5" INT. & 1.5" SURF.) H.M.A. PAVING. AFTER H.M.A. RESURFACE, RESET CORNER WITH 6"L. MAG SPIKE w/ MTL. WASHER (PLS #15748) @ ±0.15' WEST OF C.L. H.M.A. JOINT. CORNER IS ALIGNED ±2.7' SOUTH OF EXISTING FENCE LINE TO WEST, AND FURTHER ALIGNED (±) WITH CHAINLINK FENCE TO EAST (GAS SUBSTATION).

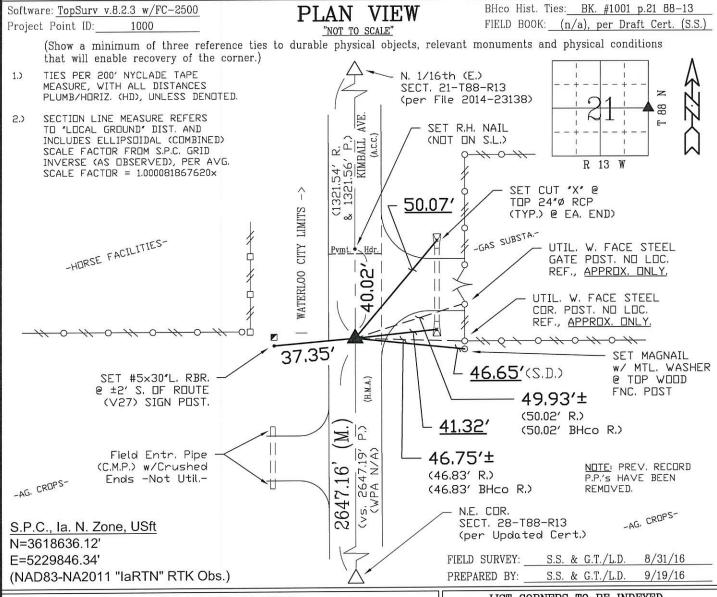

<u>CERTIFICATION</u>

ED LAND SUR GEOFFRY 9 ALLEN TINKER 15748 * IOWA *

I hereby certify that this land surveying document was prepared and the related survey work was performed by me or under my direct personal supervision and that I am a duly licensed Land Surveyor under the laws of the State of Iowa.

Mentpuy Tinker (date)

15748 License Number_

My license renewal date is December 31,_ Pages or sheets covered by this seal:

This Land Corner Certificate Only

	LIST	CORNERS	TO	BE	INDEXED
Cor	ner	Section	_	To	wnship -

Range E. 1/4 Cor. 21 88 N. 13 W. 13 W. 22 88 N. W. 1/4 Cor.



PREPARED BY:

BLACK HAWK COUNTY ENGINEER'S DEPT. 316 E. FIFTH ST., RM, 211 WATERLOO, IA. 50703 PH. 319-833-3008 FAX. 319-833-3139 surveyor@co.black-hawk.ia.us