

INDEX 18
MARGIN
PROOF
COMPARE

BLACK HAWK COUNTY IOWA:SS 021432
Filed for record FEB 6, 2002 at
11:30A.M. and recorded in Book
of Page

William J. King RECORDER
FEE 1-5.00/

WAYNE CLAASSEN ENGINEERING & SURVEYING LTD

SLSI 9-90

UNITED STATES PUBLIC LAND SURVEY CORNER CERTIFICATE

OF

Land Survey Monuments situated in Section 21, Township 88N, Range
13W, of the Fifth Principal Meridian, BLACK HAWK County, Iowa.
Previously recorded in N/A in County Recorder's Office.
(book, page, document number, etc.)


(Show reason for preparing this certificate, the evidence and detailed procedures used in establishing the corner positions and monumentation found or placed.)

Monument Description and Remarks: (SW COR) - FOUND SOM 16" DEEP, SET 1 1/2" X 14"

REBAR & CAP 8033 OVER.

PLAN - VIEW

(Show a minimum of three reference ties to durable physical objects, relevant monuments and physical conditions that will enable recovery of the corner.)

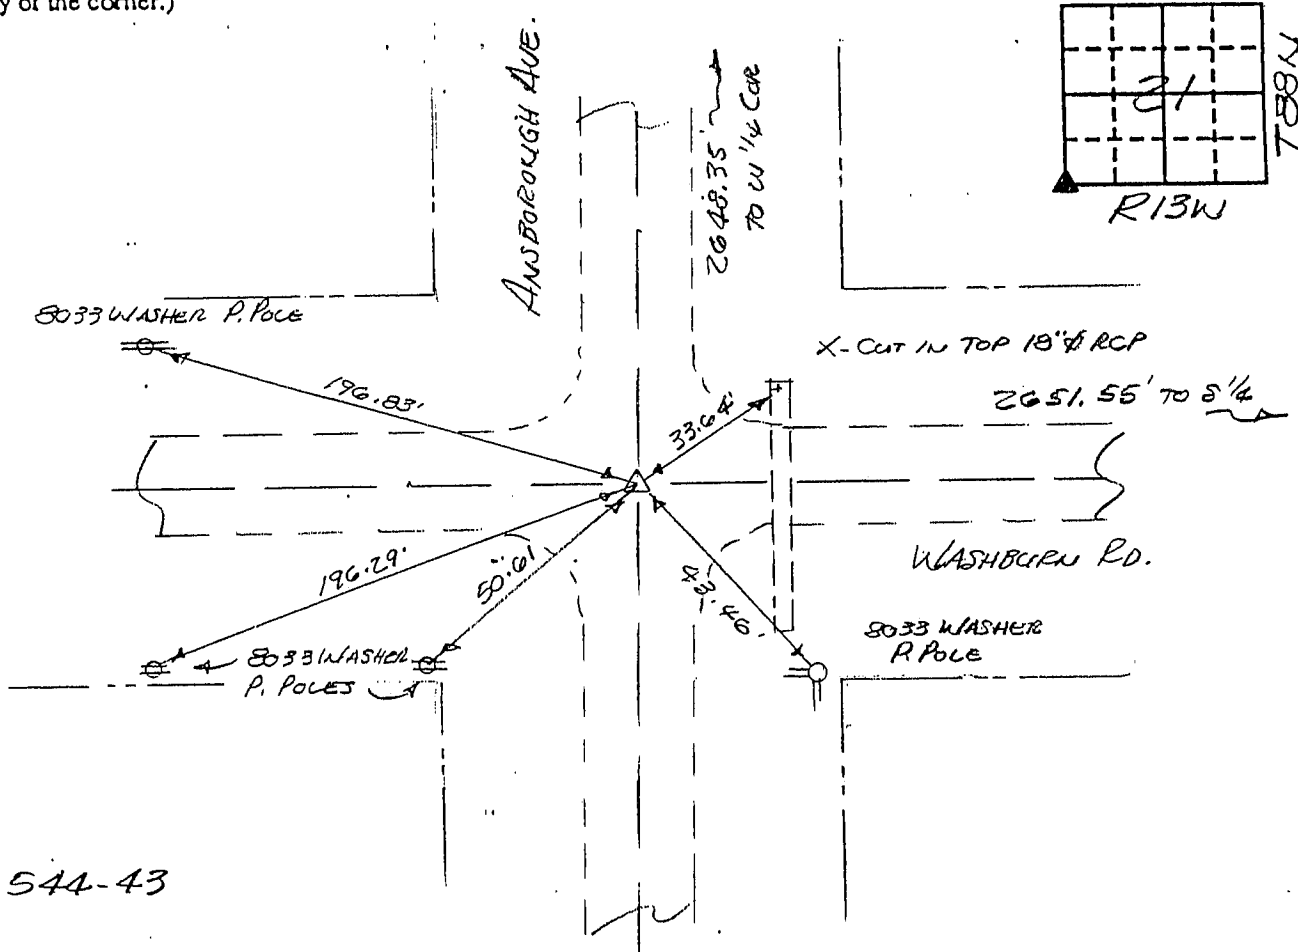

544-43

I hereby certify that the survey work was completed and this certificate was prepared by me or under my direct personal supervision and that I am a duly registered land surveyor under the laws of the state of Iowa.

Signature: F. William King

Name typed or printed: F. WILLIAM KING

Date: FEB 4, 2002 Reg. No. 8033

Corners	List Corners to be Indexed	Section	Twp	Range
SW	21	88N	13W	

SEAL

