

021431

Patricia A. Liso RECORDER

FEE 1-5.00/ .

WAYNE CLAASSEN ENGINEERING & SURVEYING INC

SLSI 9-90

UNITED STATES PUBLIC LAND SURVEY CORNER CERTIFICATE

OF

Land Survey Monuments situated in Section 21, Township 98N, Range 13W, of the Fifth Principal Meridian, BLACK HAWK County, Iowa. Previously recorded in N/A in County Recorder's Office.

(book, page, document number, etc.)


(Show reason for preparing this certificate, the evidence and detailed procedures used in establishing the corner positions and monumentation found or placed.)

Monument Description and Remarks: W^{1/4} FOUND BROKEN SCM 6" DEEP IN GRAVEL

POSD. SET 1/2" Ø REBAR ON EAST SIDE OF MONUMENT 9" DEEP.

PLAN - VIEW

(Show a minimum of three reference ties to durable physical objects, relevant monuments and physical conditions that will enable recovery of the corner.)

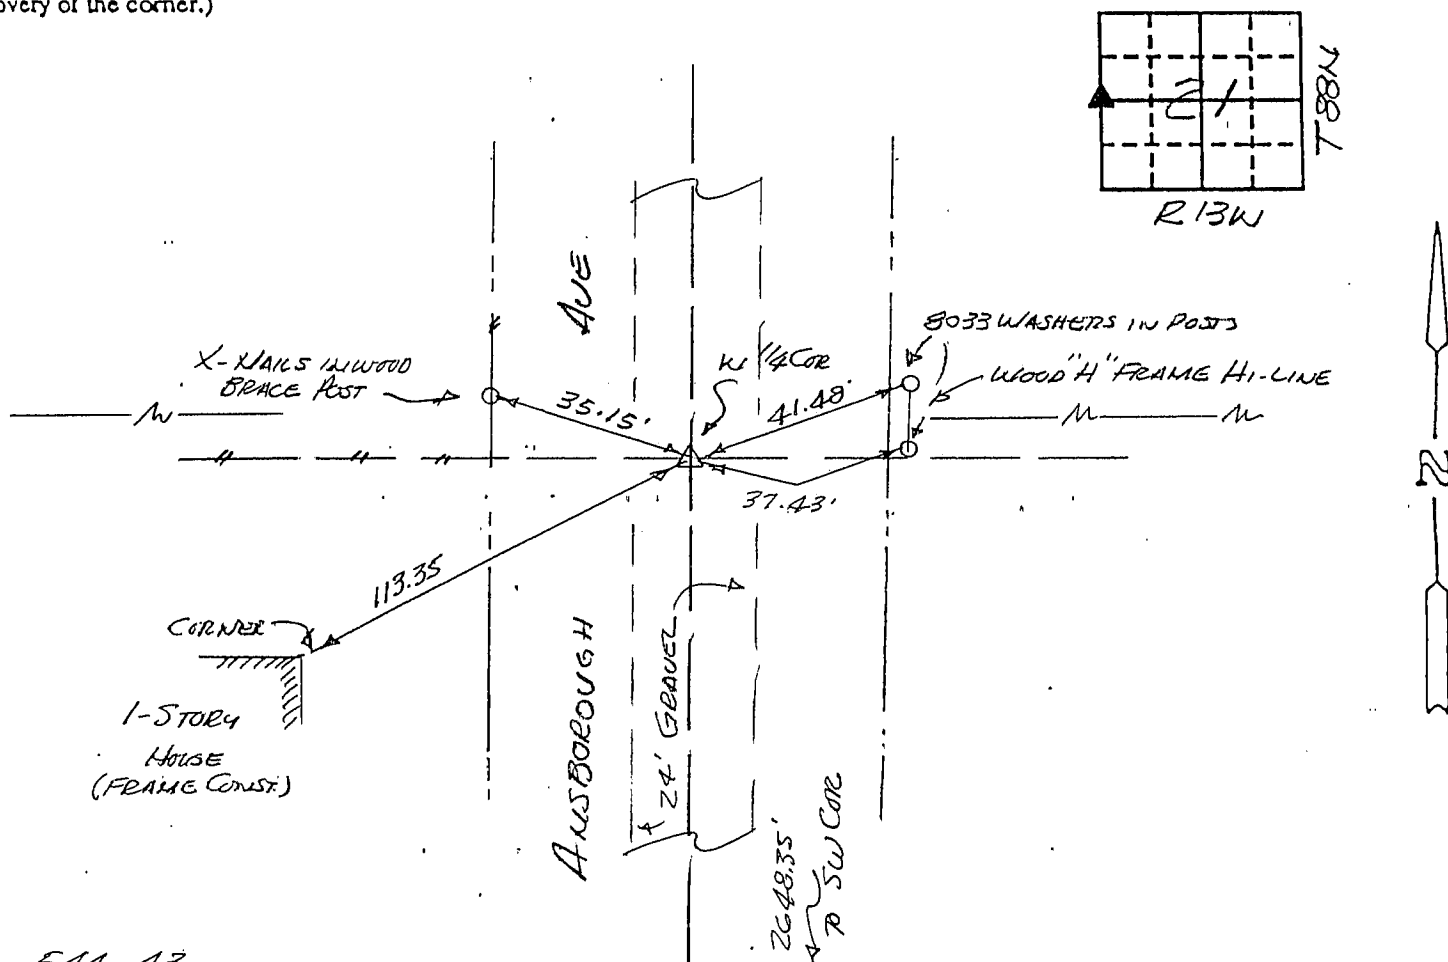

544-43

I hereby certify that the survey work was completed and this certificate was prepared by me or under my direct personal supervision and that I am a duly registered land surveyor under the laws of the state of Iowa.

Signature: F. William King
Name typed or printed: F. WILLIAM KING
Date: FEB. 4, 2002 Reg. No. 8033

Date: FEB. 4, 2002 Reg. No. 8033

Corners	Section	Twp	Range
W 1/4	21	88N	13W

