

SC ✓
Misc INDEX *ccp*
BLACK HAWK COUNTY IOWA SS
Filed for record May 14, 1996 at
3:30 PM and recorded in Book 320
PROOF of Misc Page 501
COMPARE

21245

Michael R. Fagle Recorder
Fee 1-5.00x

County Assessor

Michael R. Fagle L.S. - RUST - 501 Sycamore ST. Suite 222 Waterloo, Iowa 50703 - 1-319-232-6531
SL 519-90

UNITED STATES PUBLIC LAND SURVEY CORNER CERTIFICATE

OF

Land Survey Monuments situated in Section 22 Township 88 NORTH Range 13 WEST of the Fifth Principal Meridian, BLACK HAWK County, Iowa.
Previously recorded in _____ in County Recorder's Office.

(book, page, document number, etc.)
(Show reason for preparing this certificate, the evidence and detailed procedures used in establishing the corner: positions and monumentation found or placed.)

Monument Description and Remarks:





N 1/4 CORNER - 1/2" REBAR

NE CORNER - 1/2" REBAR

CENTER SECTION - PINCH TOP PIPE

PLAN - VIEW

(Show a minimum of three reference ties to durable physical objects, relevant monuments and physical conditions that will enable recovery of the corner.)

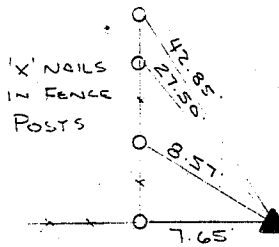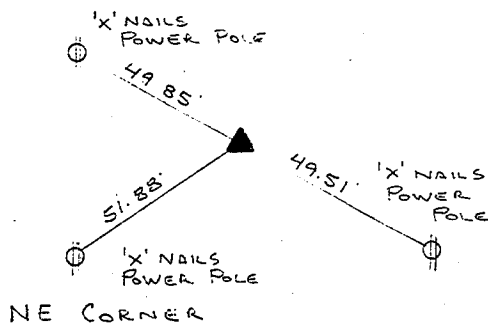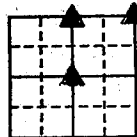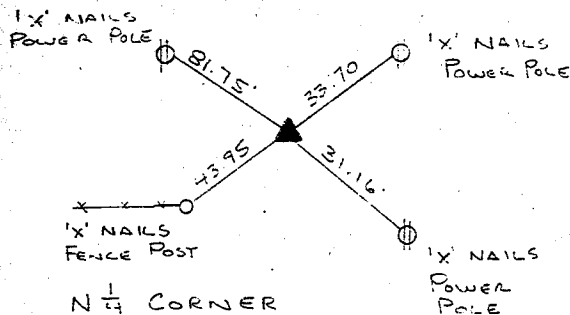


I hereby certify that the survey work was completed and this certificate was prepared by me or under my direct personal supervision and that I am a duly registered land surveyor under the laws of the state of Iowa.

Signature: *Michael R. Fagle*
Name typed or printed: Michael R. Fagle, L.S.

Date: 5-14-96 Reg. No. 8505

My registration renewal date is December 31, 1996

SEAL

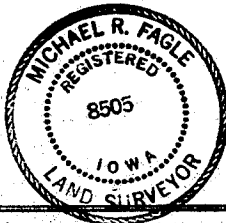

Corners	List Corners to be Indexed Section	Twp	Range
N 1/4	22	88 N	13 W
NE	22	88 N	13 W
CENTER	22	88 N	13 W

320-501

320-501