Doc ID: 004234080001 Type: GEN Kind: CORNER Recorded: 08/24/2010 at 11:55:23 AM Fee Amt: \$9.00 Page 1 of 1 Black Hawk County Iowa JUDITH A MCCARTHY RECORDER File 2011-0003529

Michael R. Fagle, P.L.S.

AECOM, 501 Sycamore St., Suite 222, Waterloo, Iowa 50703

1-319-232-653

UNITED STATES PUBLIC LAND SURVEY CORNER CERTIFICATE OF


Land Survey Monuments situated in Section_	23 . Township $^{-}$	88 North
Range 13 West , of the Fifth Principal		BLACK HAWK
County, lowa. Previously recorded in	•	
in County Recorder's Office.	(Book, Page, Dacument	Number, etc.)


(Show reason for preparing this certificate, the evidence and detailed procedures used in establishing the corner positions and monumentation found or placed.)

Monument Description and Remarks: EXCAVATED A 3'X 4'HOLE AND PROBED FOR MONUMENT COULD NOT FIND MONUMENT. SET 1/2" REBAR/YELLOW PLASTIC NO. 8505 INSIDE A 1:/4" DIA. PIPE. THE LOCATION WAS DETERMINED BY USING THE CHAINING NOTES AND THE FOUND NORTHEAST CORNER AND FOUND SOUTHHEAST CORNER.

PLAN - VIEW

(Show a minimum of three reference ties to durable physical objects, relevant monuments and physical conditions that will enable recovery of the corner.)

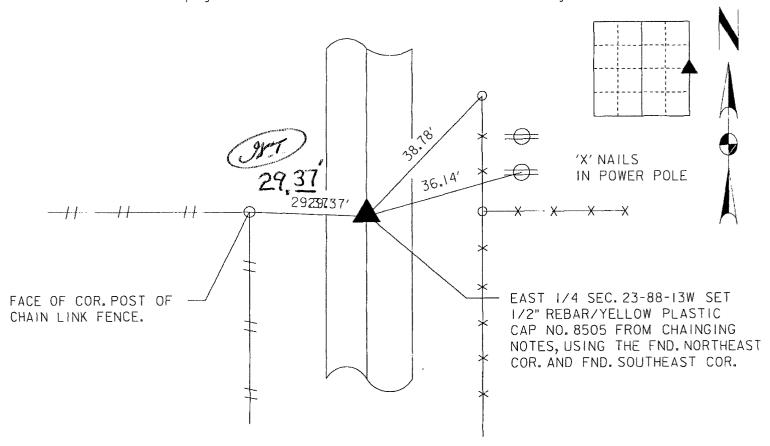

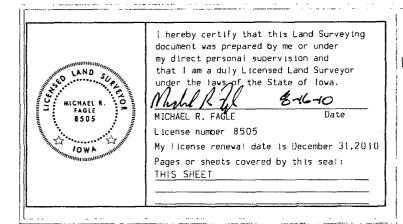

List Corners to be Indexed

Corners Section Twp Range

EAST 1/4 CORNER 23 T 88 N R 13 W