



Doc ID: 005634370001 Type: GEN  
 Recorded: 12/05/2014 at 12:02:40 PM  
 Fee Amt: \$7.00 Page 1 of 1  
 Black Hawk County Iowa  
 JUDITH A MCCARTHY RECORDER  
 File **2015-00009467**

Prepared by & Return to: Herald - Reicks Surveying, 10 East Main Street, New Hampton, IA 50659, Ph. 641-394-2725

## UNITED STATES PUBLIC LAND SURVEY CORNER CERTIFICATE

Land Survey Monuments situated in Section **25**, Township **88** North, Range **13** West of the Fifth Principal Meridian, **Black Hawk** County, Iowa. **1 & 2.**) Previously recorded in Doc. #2005-19155 in the County Recorder's office.

This certificate is being prepared in compliance with Iowa Code Chapter 355.11 because:

- |   |                                     |   |
|---|-------------------------------------|---|
| } | <input type="checkbox"/>            | There is no certificate on file for this corner.  |
|   | <input type="checkbox"/>            | There are no longer three valid ties of record.   |
|   | <input checked="" type="checkbox"/> | There are changes to reference ties of record.    |
|   | <input checked="" type="checkbox"/> | There is change of monumentation of record.       |
|   | <input type="checkbox"/>            | To clarify description of record monument (ties). |


Monument Description and Remarks:

**1.) Southeast Corner:** Set 1"Ø Bronze Survey Marker PLS 19211 at previous location (Found 5/8"Ø Rebar) by means of coordinates obtained prior to highway reconstruction, Project No. FM-TSF-C007(130)--5B-07.

**2.) Northeast Corner SE 1/4 - SE 1/4:** Set 1"Ø Bronze Survey Marker PLS 19211 at previous location (Found Mag Nail) by means of coordinates obtained prior to highway reconstruction, Project No. FM-TSF-C007(130)--5B-07.

### PLAN - VIEW

(Show a minimum of three reference ties to durable physical objects, relevant monuments and physical conditions that will enable recovery of the corner.)

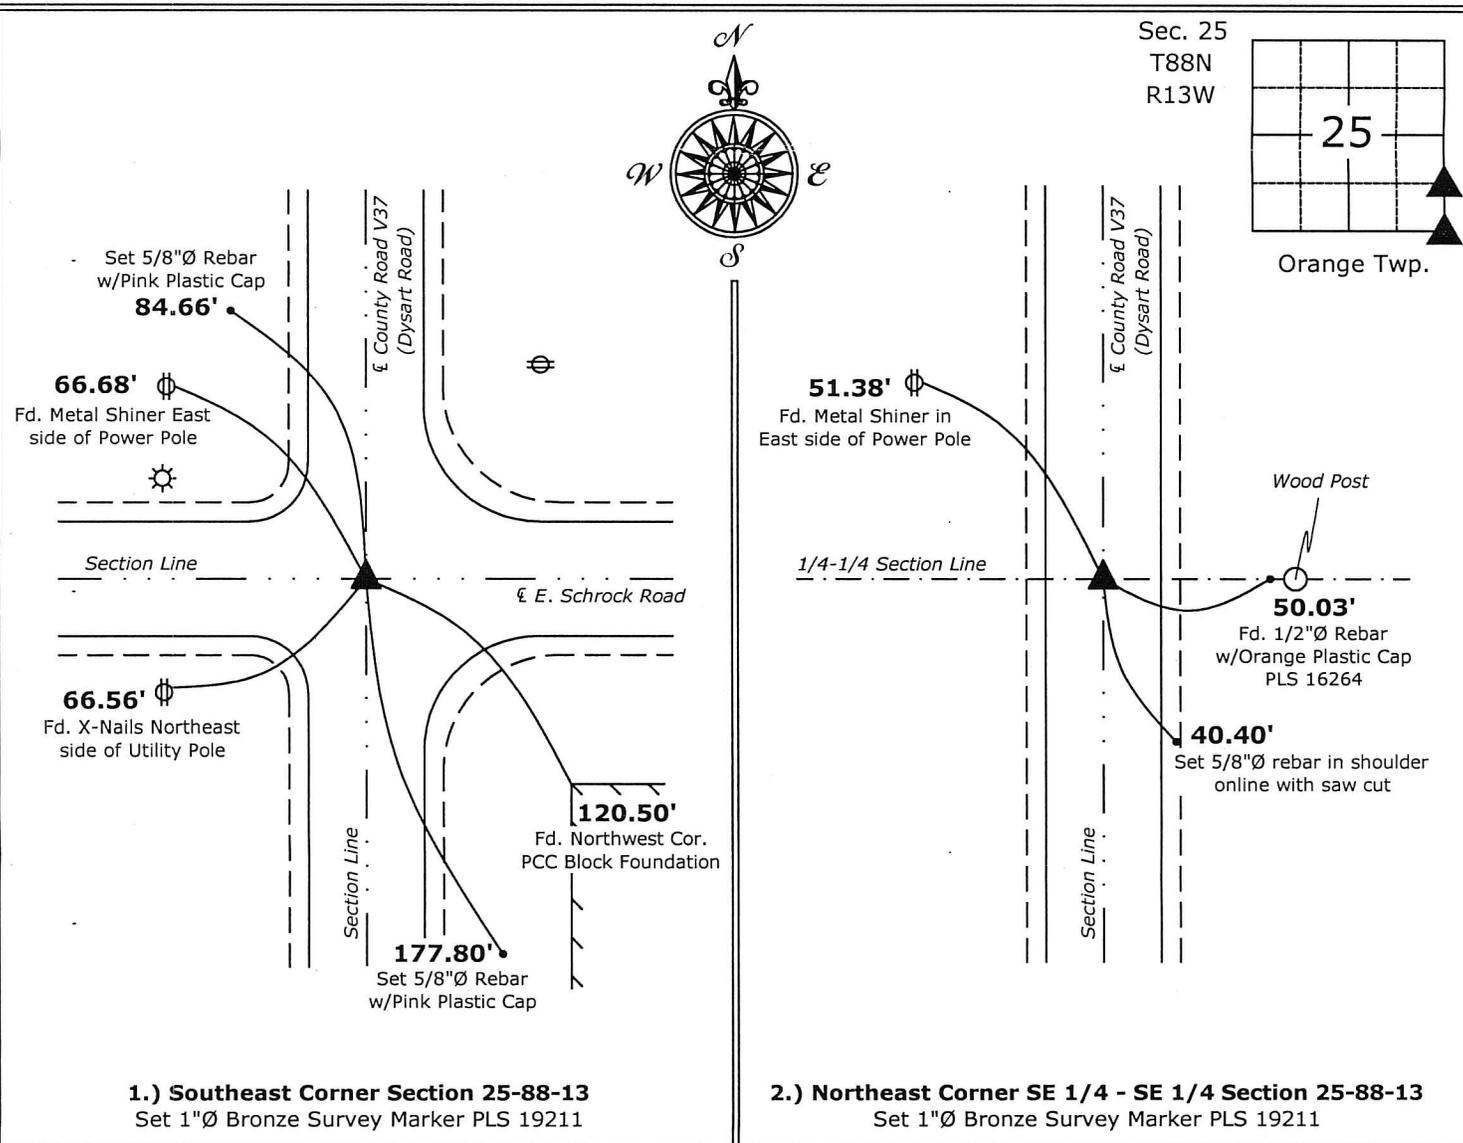

I hereby certify that this land surveying document was prepared and the related survey work was performed by me or under my direct personal supervision and that I am a duly licensed Land Surveyor under the laws of the State of Iowa.

*Kirk D. Reicks 12-4-14*  
 Kirk D. Reicks Date:

License number 19211  
 My license renewal date is December 31, 2014.  
 Sheets covered by this seal: Individual sheet only

List Corners to be Indexed			
Corners	Section	Twp.	Range
SE	25	88	13
NE-SE-SE	25	88	13
Project Number: 2014-135			
FB: Black Hawk County 1, Pg. 17			