


UNITED STATES PUBLIC LAND SURVEY CORNER CERTIFICATE
OF

Land Survey Monuments situated in Section 33, Township 88N, Range 13W, of the Fifth Principal Meridian, BLACK HAWK County, Iowa.
Previously recorded in _____ in County Recorder's Office.
(book, page, document number, etc.)
(Show reason for preparing this certificate, the evidence and detailed procedures used in establishing the corner positions and monumentation found or placed.)
Monument Description and Remarks: FOUND 1" DIA. SOLID PIN IN CL ROAD


PLAN - VIEW

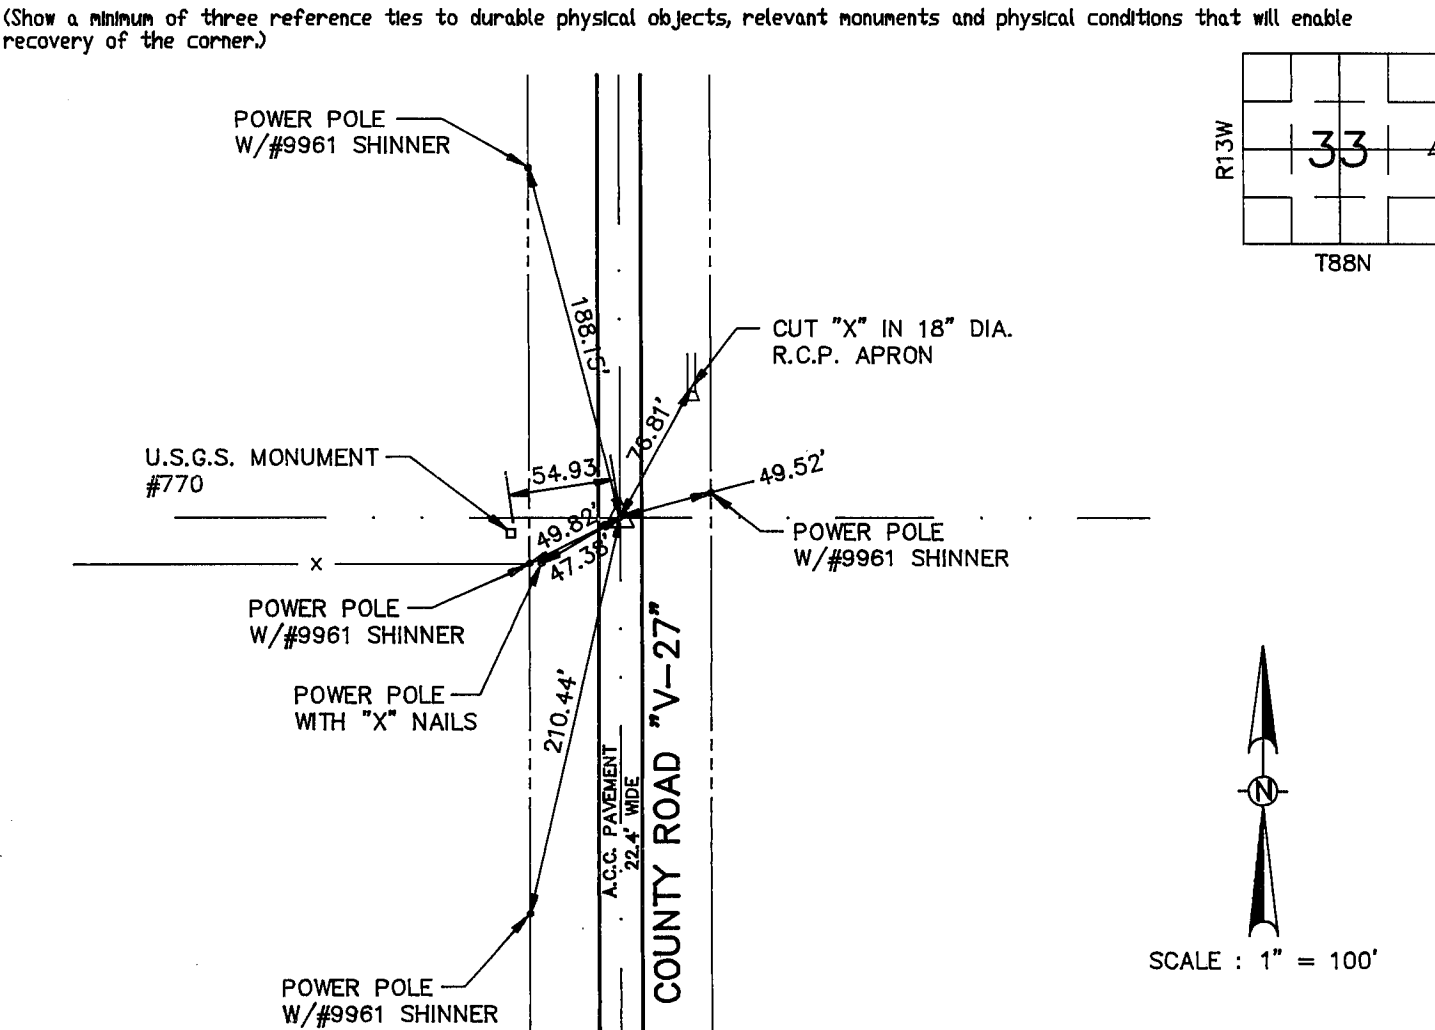

I hereby certify that the survey work was completed and this certificate was prepared by me or under my direct personal supervision and that I am a duly registered land surveyor under the laws of the state of Iowa.

Signature: Kirk D. Eschliman
Name typed or printed: Kirk D. Eschliman

Date: 08/17/92 Reg. No. Ia. R.L.S. 9961
My Registration Expires December 31, 1993

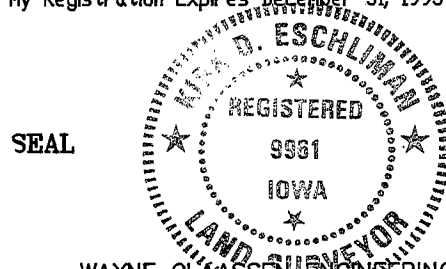

WAYNE CLAASSEN ENGINEERING AND SURVEYING, INC.
WATERLOO, IOWA
FIELD BOOK N.N.G. 12 PROJECT NO. W.O. S42181

Corners	List Corners to be Indexed Section	Indexed Twp	Range
E 1/4	33	T88N	R13W

MISC. BK. 302 p. 511