

Env WAYNE CLAASSEN ENGINEERING AND SURVEYING, INC.  
P.O. BOX 898 WATERLOO, IOWA 50704-0898

PHONE: (VOICE) 319-235-6294  
(FAX) 319-235-0028

## UNITED STATES PUBLIC LAND SURVEY CORNER CERTIFICATE


Land Survey Monuments situated in Section 35, Township 88 North, Range 13 West, of the Fifth Principal Meridian, Black Hawk County, Iowa.

Previously recorded in N/A in County Recorder's Office.  
(book, page, document number, etc.)

Monument Description and Remarks

No certificate on file. Set 1/2" x 24" pin and red cap #16775 at midpoint between Center of section and the South quarter corner.

### PLAN - VIEW

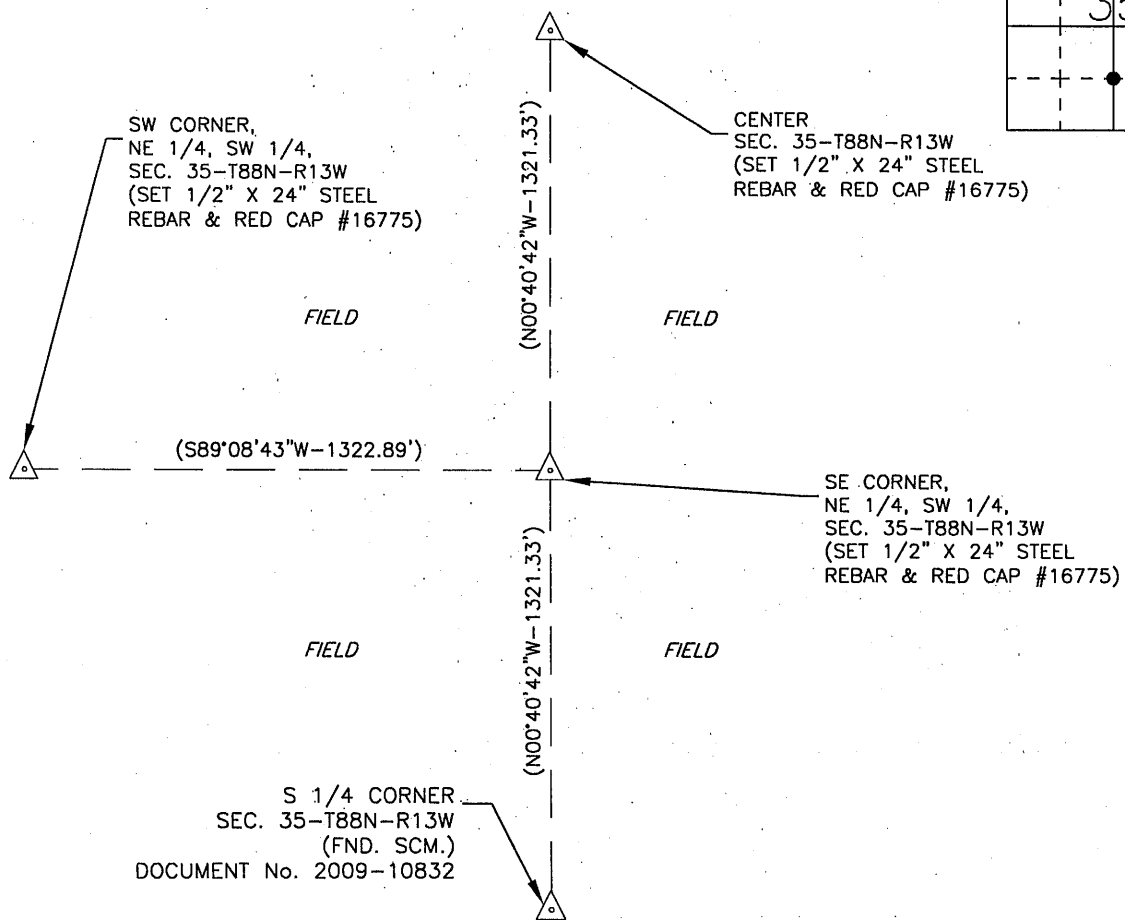

BK 605, PG. 80

I hereby certify that this land surveying document was prepared and the related survey work was performed by me or under my direct personal supervision and that I am a duly Licensed Land Surveyor under the laws of the State of Iowa.

Signature: David L. Scheil

David L. Scheil, L.S.

Date: July 26, 2013 Lic. No. 16775


Pages or Sheets Covered by this Seal: THIS SHEET ONLY.

My license renewal date is December 31, 2014

SEAL

#### List Corners to be Indexed

Corners	Section	Twp	Range
SE CORNER	35	88 N	13 W
NE 1/4, SW 1/4			

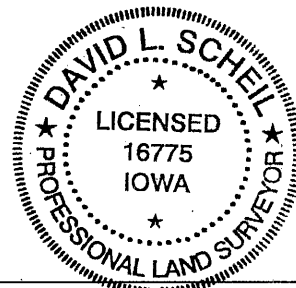

(7.00)