

SLSI 9-90

UNITED STATES PUBLIC LAND SURVEY CORNER CERTIFICATE

OF

Land Survey Monuments situated in Section 1, Township 88N, Range 14W, of the Fifth Principal Meridian, _____ County, Iowa.
Previously recorded in N/A in County Recorder's Office.


(book, page, document number, etc.)

(Show reason for preparing this certificate, the evidence and detailed procedures used in establishing the corner positions and monumentation found or placed.)

Monument Description and Remarks: FOUND X CUT IN 1 1/2" Ø LEAD PLUG 13.3' NORTH SE
SOUTH BACK CURVE CONSTRUCTION JOINT. THIS POINT WERE SET AS A PART OF THE
1979-1980 WEST RIDGEWAY PAVING PROJECT.

PLAN - VIEW

(Show a minimum of three reference ties to durable physical objects, relevant monuments and physical conditions that will enable recovery of the corner.)

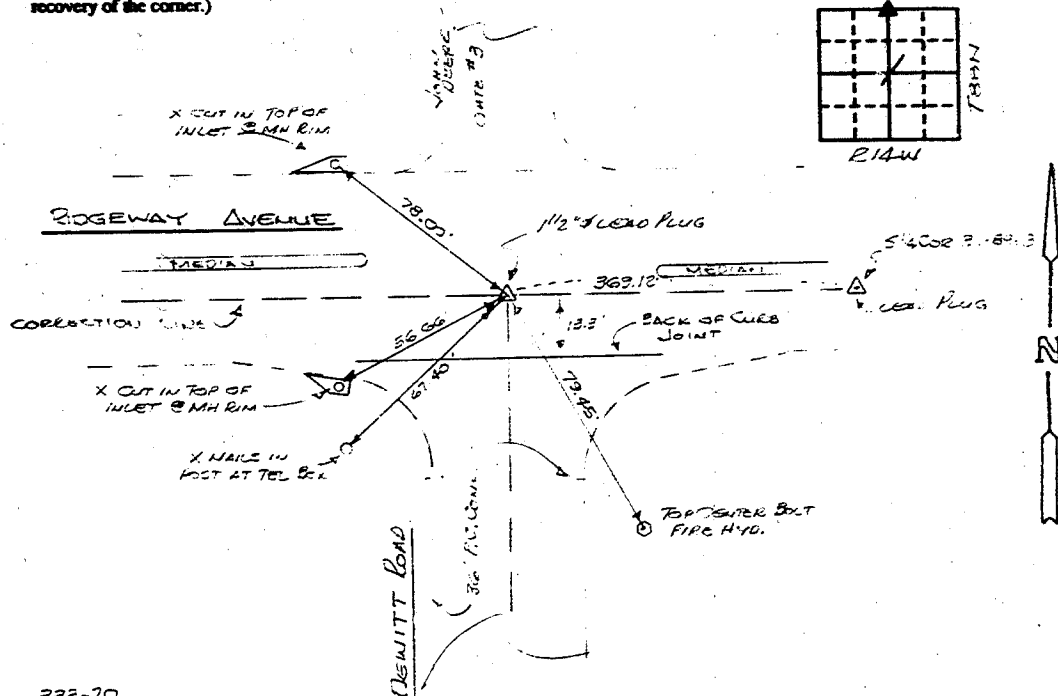

333-70


I hereby certify that the survey work was completed and this certificate was prepared by me or under my direct personal supervision and that I am a duly registered land surveyor under the laws of the state of Iowa.

Signature:

Name typed or printed: F. William KingDate: 8-29-91Reg. No. 8033

Corners	List Corners to be Indexed	Section	Twp	Range
<u>N 1/4</u>	<u>1</u>	<u>88N</u>	<u>14W</u>	

SEAL

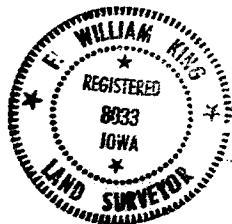

297-1481