


Doc ID: 006793350001 Type: GEN Recorded: 06/24/2015 at 12:44:10 PM Fee Amt: \$7.00 Page 1 of 1 Black Hawk County Iowa SANDIE L. SMITH RECORDER


File 2015-00021103

 

Land Survey Monuments situated in Section No. ___, Township No. 14 West , of the Fifth Principal Meridian,_ Range No._ Black Hawk County, Iowa Previously recorded in . 333 Misc. 024 Show reason for preparing this certificate, the evidence and detailed procedures used in establishing the corner positions and monumentation found or placed.) Monument Description and Remarks: Northwest Corner, East Half, Northeast Quarter, Section 2 T88N R14W Corner Certificate 333 Misc. 024 calls finding an Iowa DOT Land Corner Monumnet, searched area and found 2.5"Ø Aluminum Iowa DOT Land Corner Monument flush in concrete paving. Corner was used for a survey in the NE 1/4 of Section 2 T88N R14W. This corner certificate is being prepared because there are no longer three reference ties

PLAN - VIEW

(Show a minimum of three reference ties to durable physical objects, relevant monuments and physical conditions that will enable recovery of the corner.)

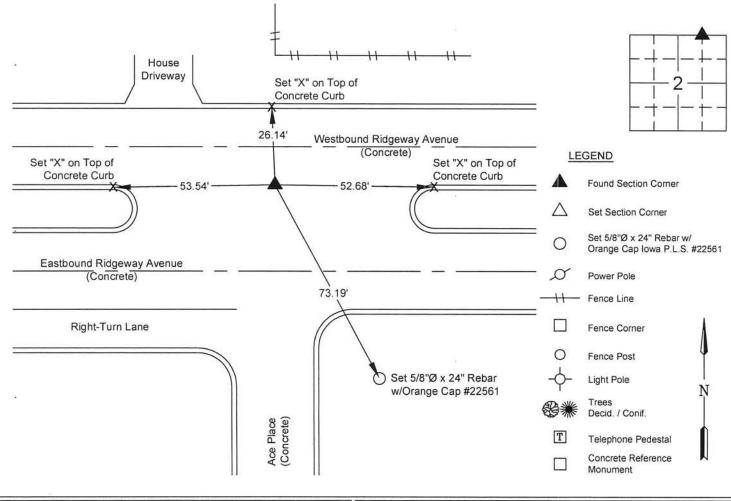



I hereby certify that this land surveying document was prepared and the related survey work was performed by me or under my direct personal supervision and that I am a duly licensed Land Surveyor under the laws of the State of Iowa

6.22-15 Matthew A. Kofta, P.L.S. Date

License Number 22561 My license renewal date is December 31, 2016 Pages or sheets covered by this seal:

List Corner to be Indexed

Corner Section

Range

Northwest Corner East Half

Northeast Quarter

88 North

14 West

VJ Engineering 1501 Technology Parkway Cedar Falls, lowa - 319-266-5829

Section Corner Reference Ties file no. 158051

drawn by