



1-319-232-6531

Land Survey Monuments situated in Section 2, Township 88 North
Range 14 West, of the Fifth Principal Meridian, Black Hawk
County, Iowa. Previously recorded in Fee Book 2006 531
in County Engineer's Office. (Book, Page, Document Number, etc.)

(Show reason for preparing this certificate, the evidence and detailed procedures used in establishing the corner positions and monumentation found or placed.)

Monument Description and Remarks: Did not find PK Nail with Washer
After the construction was completed on the City of Cedar Falls Ridgeway Avenue
Reconstruction Project (RC-000-1913) a 2" Brass Disc with Magnetic Washer was
set from coordinates of corner in Plan Set. Stamped LS 8505 - S 36 - W 1/16 S 2.

(Show a minimum of three reference ties to durable physical objects, relevant monuments and physical conditions that will enable recovery of the corner.)

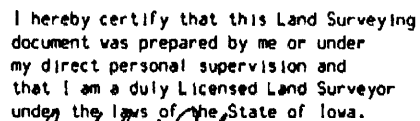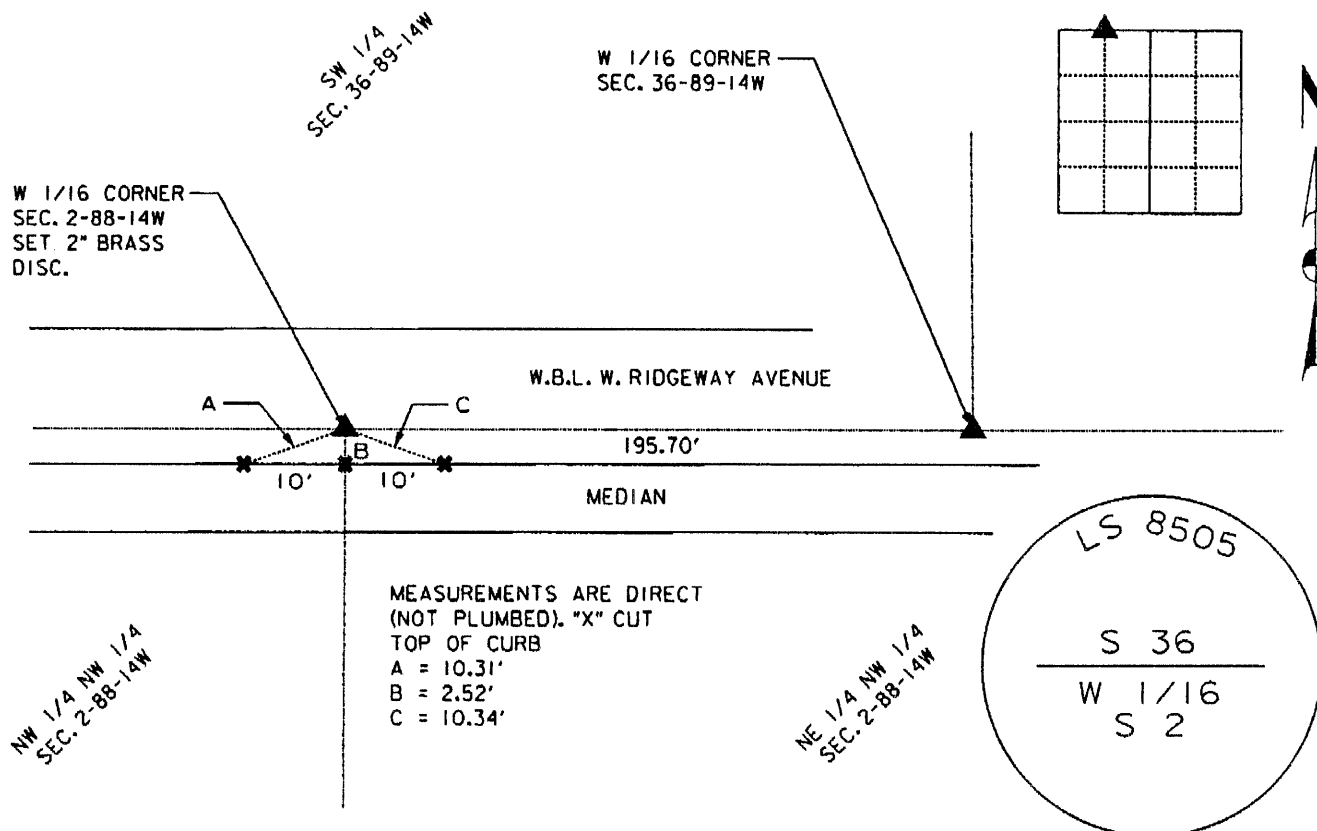

Michael R. Eagle 12-01-2011
MICHAEL R. EAGLE Date

License number 8505

My license renewal date is December 31, 2012

Pages or sheets covered by this seal:

THIS SHEET

List Corners to be Indexed

Corners	Section	Twp	Range
WEST 1/16 Corner	2	T 88 N	R 14 W