

* Prepared By: VJ Engineering, Matthew A. Kofta, P.L.S., 1501 Technology Parkway, Suite 100, Cedar Falls, Iowa, 50613, (319) 266-5829

United States Public Land Survey Corner Certificate of

Land Survey Monuments situated in Section No. 3, Township No. 88 North,
Range No. 14 West, of the Fifth Principal Meridian, Black Hawk County, Iowa
Previously recorded in 343 Misc 508.

Show reason for preparing this certificate, the evidence and detailed procedures used in establishing the corner positions and monumentation found or placed.)


Monument Description and Remarks: Southwest Corner -- Section 3 - T88N - R14W

Previous corner certificate calls out finding a pinched pipe at the corner location. Searched area as indicated by previous certificate and found
3/4"Ø pinched pipe, used found pinched pipe as the corner.

This corner certificate is being prepared to update the reference ties.

PLAN - VIEW

(Show a minimum of three reference ties to durable physical objects, relevant monuments and physical conditions that will enable recovery of the corner.)

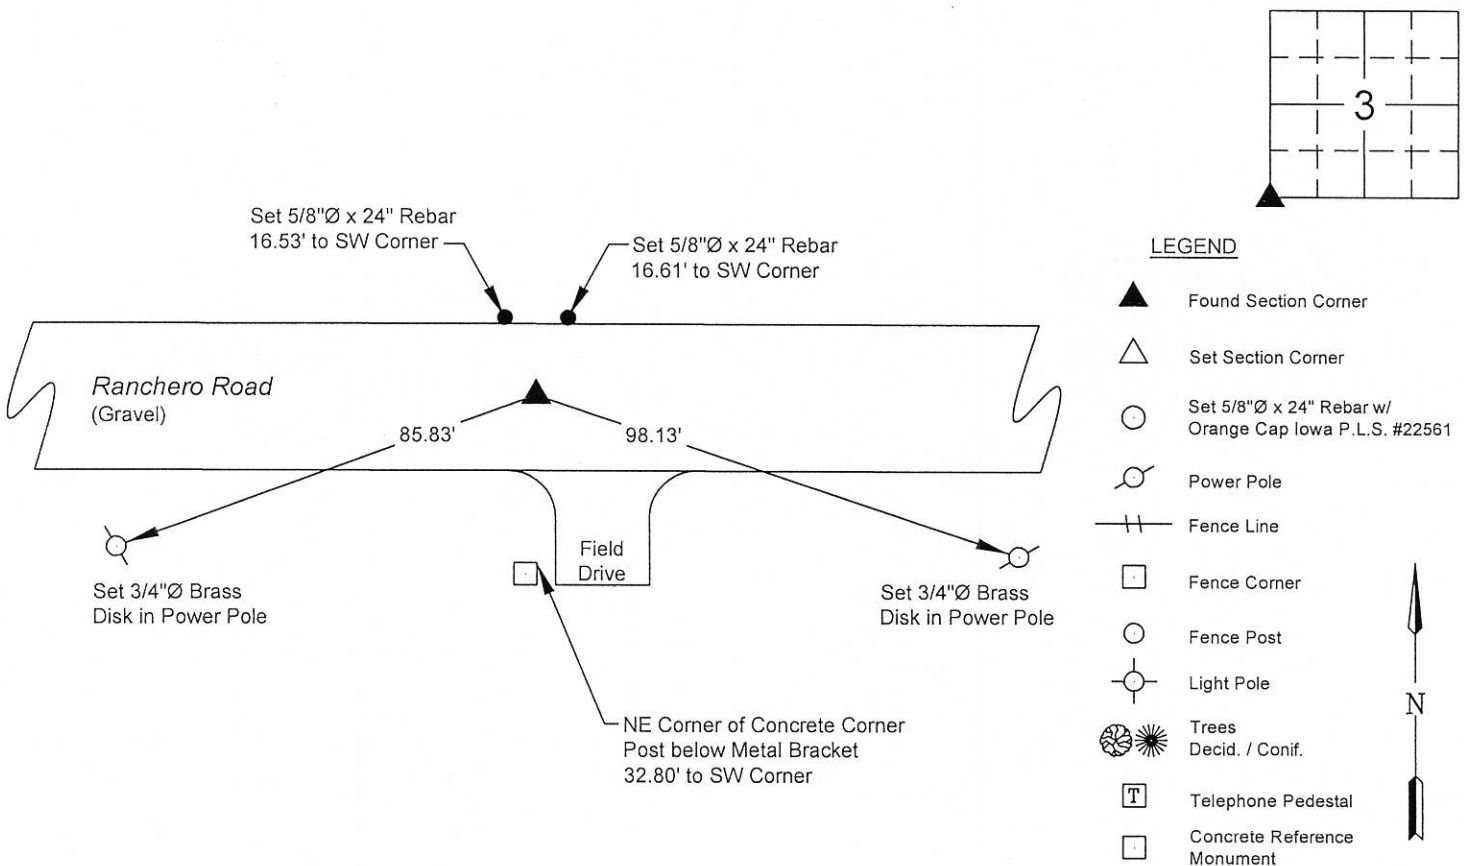

I hereby certify that this land surveying document was prepared and the related survey work was performed by me or under my direct personal supervision and that I am a duly licensed Land Surveyor under the laws of the State of Iowa.

Matthew A. Kofta
Matthew A. Kofta, P.L.S.
License Number 22561
My license renewal date is December 31, 2018
Pages or sheets covered by this seal: 1

List Corner to be Indexed

Corner	Section	Twp	Range
SW	3	88 N	14 W



VJ Engineering
1501 Technology Parkway
Cedar Falls, Iowa - 319-266-5829

Section Corner
Reference Ties

file no.	188038
drawn by	MAK
date	7/25/18