

ENV *

WAYNE CLAASSEN ENGINEERING AND SURVEYING, INC.
P.O. BOX 898 WATERLOO, IOWA 50704-0898

PHONE: (VOICE) 319-235-6294
(FAX) 319-235-0028

UNITED STATES PUBLIC LAND SURVEY CORNER CERTIFICATE

Land Survey Monuments situated in Section 04, Township 88 North, Range 14 West, of the Fifth Principal Meridian, Black Hawk County, Iowa.

Previously recorded in _____ in County Recorder's Office.
(book, page, document number, etc.)

Monument Description and Remarks


Corner Stone Survey for Black Hawk County & Grundy County Interstate No. 520, RF-520-5(7)--35-38 & RF-520-6(17)--35-07, signed by Charles C. Babbitt, R.L.S. No. 3513, signed 12-05-1977, show a "found limestone 12" deep Set iron pin over high point of stone Drove orange steel post by stone". Above survey shows corner near a intersection of fences. Went to location of corner and found pin and 3/4" twisted pin that reasonably matches above mentioned Corner Stone Certificate.

PLAN - VIEW

Reason for filing certificate:

- ☒ There is no certificate on file with the Recorder's Office.
- ☐ Accepts corner position which differs from the one shown in above document.
- ☐ The corner monument was replaced or modified.
- ☐ The reference ties in above document were incorrect or missing.

000.00 DENOTES RECORD DIMENSION FROM IDOT
CORNERSTONE NOTED ABOVE
(000.00) DENOTES FIELD DIMENSION

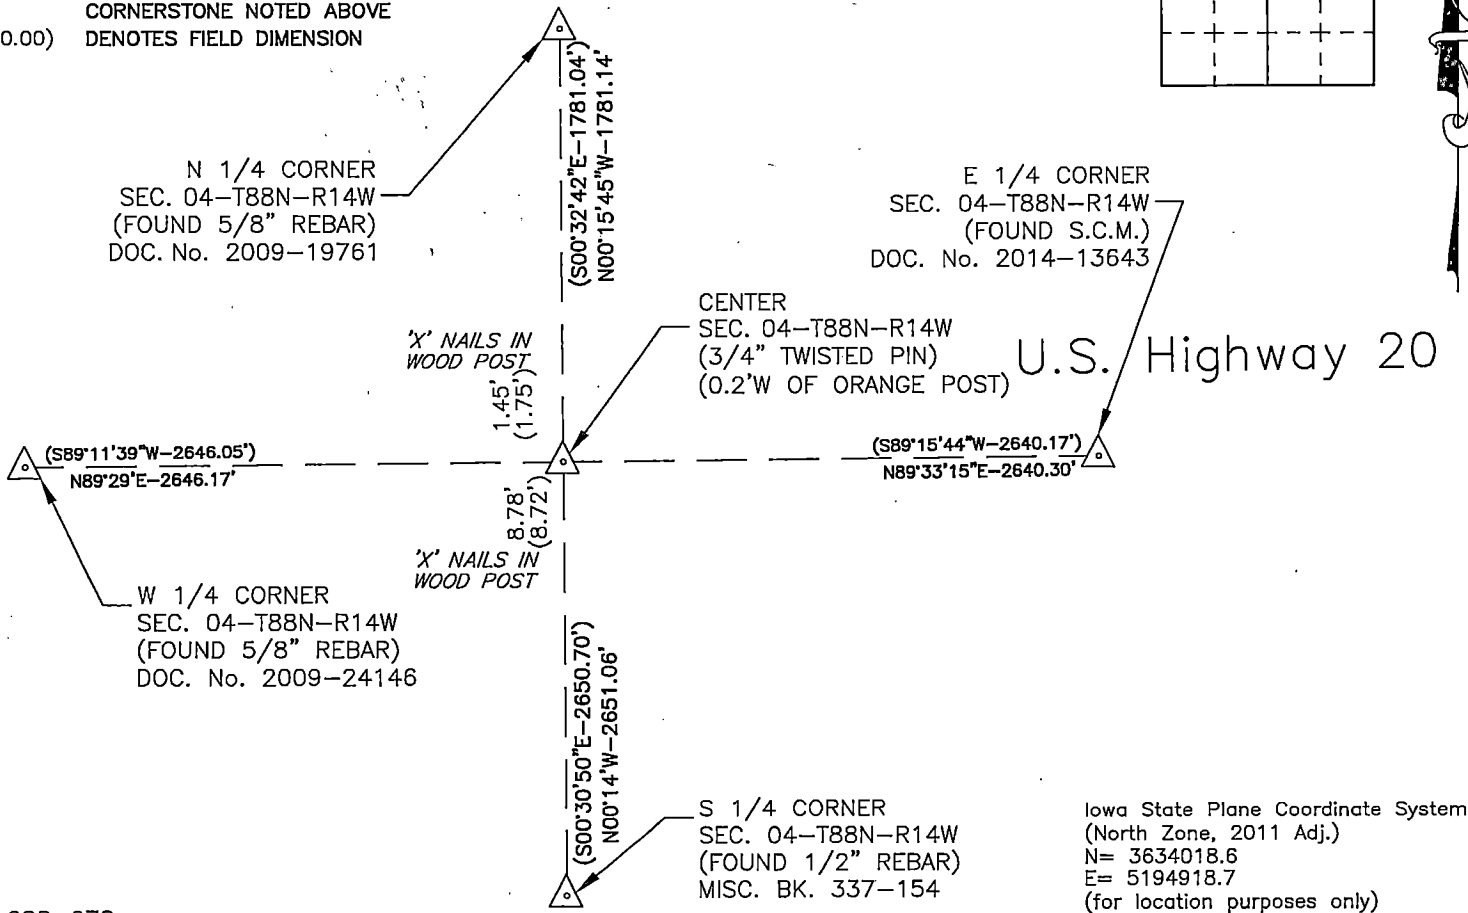

688-078

I hereby certify that this land surveying document was prepared and the related survey work was performed by me or under my direct personal supervision and that I am a duly Licensed Land Surveyor under the laws of the State of Iowa.

Signature: David L. Scheil
David L. Scheil, L.S.

Date: AUGUST 21, 2020 Lic. No. 16775

Pages or Sheets Covered by this Seal: THIS SHEET ONLY.

My license renewal date is December 31, 2020

SEAL

List Corners to be Indexed

Corners	Section	Twp	Range
CENTER,	04	88 N	14 W

