

PREPARED BY: **BLACK HAWK COUNTY ENGINEERS OFFICE**
316 E. FIFTH STREET, ROOM 211 WATERLOO, IOWA 50703
PH.# (319) 833-3008 SLSI 9-94
FAX# (319) 833-3139 CERT 12-96

UNITED STATES PUBLIC LAND SURVEY CORNER CERTIFICATE OF
Land Survey Monuments situated in Section 04, Township 88 N,
Range 14 W, of the Fifth Principal Meridian, BLACK HAWK County, Iowa.
Previously recorded in Fee Book N/A, Page N/A, in County Recorder's Office.
(Show reason for preparing this certificate): The corner monument has been Replaced or Modified, per Ia. Code 355.11(1)(c)
(Evidence and detailed procedures used in establishing the corner position(s) and monumentation found or placed.)
Monument Description and Remarks: N.E. COR. FND. P.K. NAIL @ +/- H.M.A. C.L.
JOINT. CORNER TEMP. REFERENCED PRIOR TO SCARIFICATION AND RUBBLIZATION OF
EXISTING P.C.C. ROADWAY. AFTER RESURFACING PROJECT (7"DP. x 22'W. H.M.A. PAVEMENT
ADDED) CORNER WAS RESET w/ 5/8" x 7"±L. RBR. LOCATED 0.15' S. OF NEW H.M.A. C.L.
JOINT. SET S.M. SPK. E. (FACE) OF TIMBER P.P. SET S.M. SPK. N.W.(FACE) P.P.


NOTE: ALL DISTANCES PLUMB/HORIZ.
(H.D.), "UNLESS DENOTED".

PLAN VIEW
"NOT TO SCALE"


BHco Hist. Ties: BK. #1001(04) 88-14
FIELD BOOK: BHco. #488 p.26

(Show a minimum of three reference ties to durable physical objects, relevant monuments and physical conditions that will enable recovery of the corner.)

- 1.) TIES PER EDM MEASURE IN EITHER
PRISM "OR" NON-PRISM MODE, WHILE
UTILIZING "INDIRECT" MEASURE.

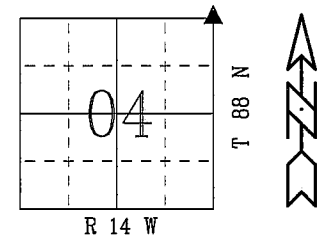


SET S.M. SPK.
@ EAST
FACE P.P.

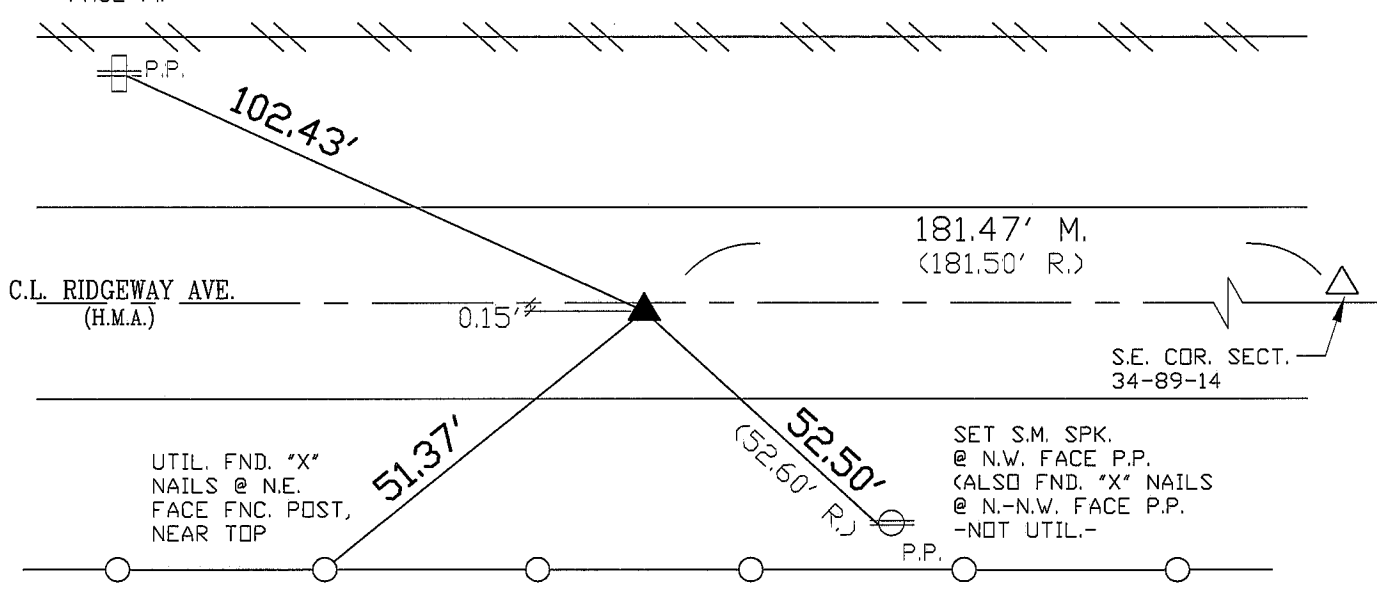

S.P.C., Ia. N. Zone, USft
N=3635824.933'
E=5197542.646'
(NAD83-2007 "BHco07", Static Obs.)

FIELD SURVEY: G.T. & J.Z. 07/11/08
PREPARED BY: C.W./J.Z./G.T. 4/20/09

CERTIFICATION

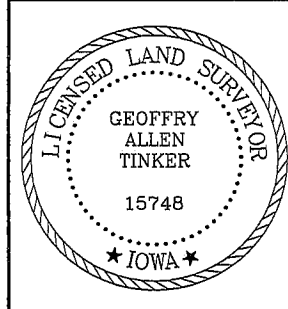

I hereby certify that this land surveying document was prepared and the related survey work was performed by me or under my direct personal supervision and that I am a duly licensed Land Surveyor under the laws of the State of Iowa.
Geoffry Allen Tinker 04/20/2009 (date)
License Number 15748
My license renewal date is December 31, 2010
Pages or sheets covered by this seal:
This Land Corner Certificate Only.

LIST CORNERS TO BE INDEXED

Corner	Section -	Township -	Range
N.E. Cor.	04	88 N	14 W
N.W. Cor.	03	88 N	14 W

INDEX OF ABBREVIATIONS

- (M) = "Measured" Dimension "NP" = Reflectoriess EDM Meas.
(P) = "Platted" Dimension "MLM" = Indirect Measure
(R) = "Record" Dimension "CM" = Concrete Monument
(C) = "Calculated" Dimension "SM" = Survey Marker Spike/Tag
"IGS" = Iowa Geodetic Survey
"WPA" = Works Progress Admin. Survey
"g" = per George Miller Survey (BHco Surveyor 1858-1860)
"b" = per John Ball Survey (BHco Surveyor 1866-1891)
"N" = per Nathan Barber Survey (BHco Surveyor 1908-1931)