

PREPARED BY: *BLACK HAWK COUNTY ENGINEERS OFFICE
316 E. FIFTH STREET, ROOM 211 WATERLOO, IOWA 50703

PH.# (319) 833-3008 SLSI 9-94
FAX.# (319) 833-3139 CERT 12-96

UNITED STATES PUBLIC LAND SURVEY CORNER CERTIFICATE OF
Land Survey Monuments situated in Section 05, Township 88 N,
Range 14 W, of the Fifth Principal Meridian, BLACK HAWK County, Iowa.
Previously recorded in Fee Book N/A, Page N/A, in County Recorder's Office.

(Show reason for preparing this certificate): The corner monument has been Replaced or Modified, per Ia. Code 355.11(1)(c)

(Evidence and detailed procedures used in establishing the corner position(s) and monumentation found or placed.)

Monument Description and Remarks: N. 1/4 COR. FND. #4 RBR. @ +/- H.M.A. C.L.
JOINT. CORNER TEMP. REFERENCED PRIOR TO SCARIFICATION AND RUBBLIZATION OF
EXISTING P.C.C. ROADWAY. AFTER RESURFACING PROJECT (7"DP. x 22'W. H.M.A. PAVEMENT
ADDED) CORNER WAS RESET w/ 5/8" x 7"±L. RBR. LOCATED 0.75' N. OF NEW H.M.A. C.L.
JOINT. SET #5 RBR. @ TOP BACKSLOPE (TYP.)


NOTE: ALL DISTANCES PLUMB/HORIZ.
(H.D.), "UNLESS DENOTED".

PLAN VIEW

BHco Hist. Ties: BK #1001 (05) 88-14
FIELD BOOK: BHco. #488 p.23

(Show a minimum of three reference ties to durable physical objects, relevant monuments and physical conditions
that will enable recovery of the corner.)

- 1.) TIES PER EDM MEASURE IN EITHER
PRISM "OR" NON-PRISM MODE, WHILE
UTILIZING "INDIRECT" MEASURE.

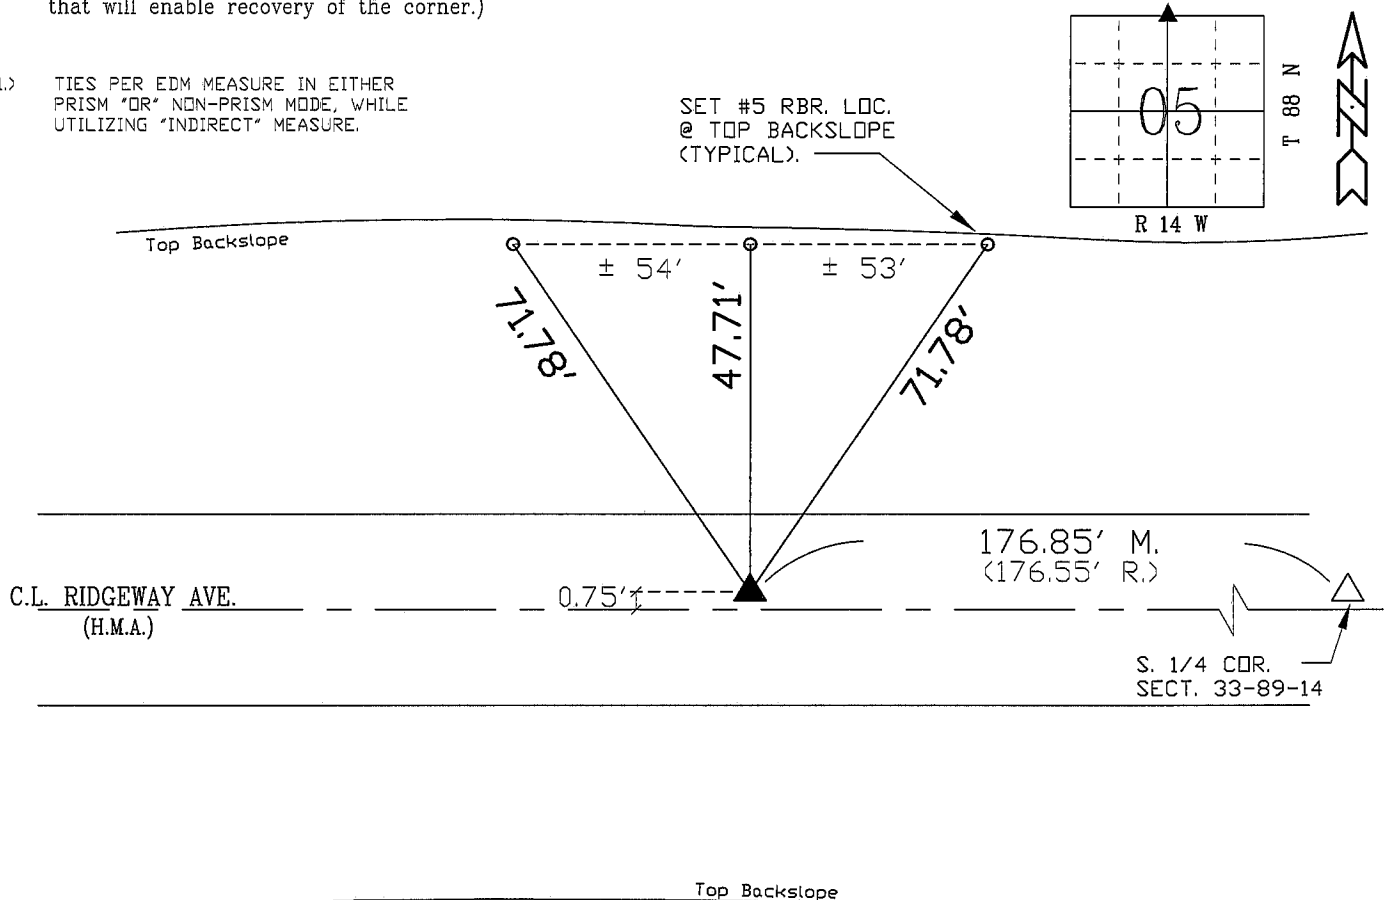

S.P.C., Ia. N. Zone, USft

N=3635745.458'


E=5189610.815'

(NAD83-2007 "BHco07", Static Obs.)

FIELD SURVEY: G.T. & J.Z. 07/11/08

PREPARED BY: C.W./J.Z./G.T. 4/17/09

CERTIFICATION

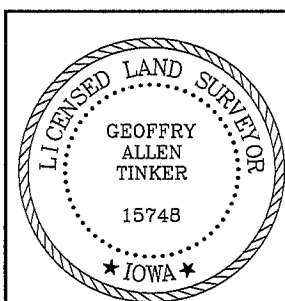

I hereby certify that this land surveying document
was prepared and the related survey work was
performed by me or under my direct personal
supervision and that I am a duly licensed Land
Surveyor under the laws of the State of Iowa.

Geoffrey Allen Tinker 04/20/2009
(date)

License Number 15748

My license renewal date is December 31, 2010

Pages or sheets covered by this seal:

This Land Corner Certificate Only.

LIST CORNERS TO BE INDEXED

Corner	Section	Township	Range
N.1/4 Cor.	05	88 N	14 W

INDEX OF ABBREVIATIONS

(M) = "Measured" Dimension	"NP" = Reflectorless EDM Meas.
(P) = "Platted" Dimension	"MLM" = Indirect Measure
(R) = "Record" Dimension	"CM" = Concrete Monument
(C) = "Calculated" Dimension	"SM" = Survey Marker Spike/Tag
"IGS" = Iowa Geodetic Survey	
"WPA" = Works Progress Admin. Survey	
"g" = per George Miller Survey (BHco Surveyor 1858-1860)	
"b" = per John Ball Survey (BHco Surveyor 1866-1891)	
"N" = per Nathan Barber Survey (BHco Surveyor 1908-1931)	