

Doc ID: 011998050001 Type: GEN Recorded: 08/25/2023 at 11:27:40 AM Fee Amt: \$0.00 Page 1 of 1 Black Hawk County Iowa SANDIE L. SMITH RECORDER File 2024-00002799

*BHC Engineer

Prepared by & Return to: Isalah M. Reicks, HRS, LLC, 2206 East Bremer Avenue, Waverly, IA 50677, Phone 319-483-5187

United States Public Land Survey Corner Certificate

Land Survey Monument situated in

Section 6, Township 88 North, Range 14 West of the Fifth Principal Meridian, Black Hawk County, Iowa. On file in Document #2009-00019758 in the County Recorder's Office.

This certificate is being prepared in compliance with Iowa Code Chapter 355.11 because:

There is no certificate on file for this corner. There are no longer three valid ties of record. There are changes to reference ties of record. There is change of monumentation of record. X To clarify description of record monument (ties).

Monument Description and Remarks:


North 1/4 Corner: Found Survey Mark Nail with Stainless Steel Washer "BHCO" on the South Line of the SW 1/4 of Section 32-T89N-R14W with information obtained from the previously recorded Section Corner Certificate.

Also found a 5/8"Ø Rebar 0.15' North of said South Line with information obtained from the previously recorded Section Corner Certificate.


Set 1"Ø Bronze Survey Marker PLS 22468 with coordinates of the found location (Survey Mark Nail with Stainless Steel Washer "BHCO") obtained prior to highway reconstruction. Reset both corners in conjunction with Project No. LFM-5025--7X-07.

Plan View - Not to Scale

(Show a minimum of three reference ties to durable physical objects, relevant monuments and physical conditions that will enable recovery of the corner.)

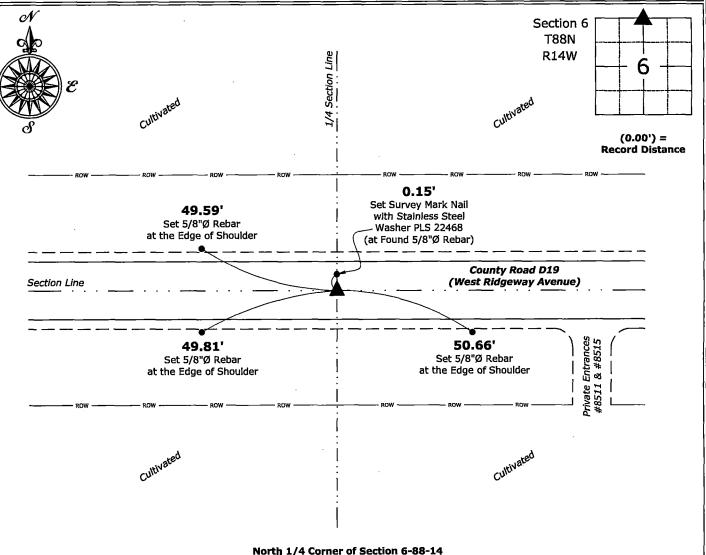

Set 1"Ø Bronze Survey Marker PLS 22468

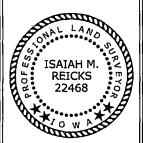

I hereby certify that this land surveying document was prepared and the related survey work was performed by me or under my direct personal supervision and that I am a duly licensed Land Surveyor under the laws of the State of Iowa.

Isaiah M. Reicks

-23-23 Date:

License number 22468

My license renewal date is December 31, 2023. Sheets covered by this seal: Individual sheet only N 1/4 6 88 14 Project Number: 2023-533 FB: Black Hawk 11, Page(s) 11-12

Township

Range

List Corner to be Indexed

Section

Corner

Projects - WO\County Control Systems_WO\BLACK HAWK\BHCO-15\BHCO-15-2023.dwg, 8/23/2023 11:16:19 AM