

INDEX BLACK HAWK COUNTY, IOWA:ss FEE BOOK # 20 05 01163  
 PROOF FILED FOR RECORD JUL 14 2004 AT 10:00 A. M. FEE 1-5.00/ - 1.00/  
 COMPARED *Patrick J. Less* BLACK HAWK COUNTY RECORDER

ENV KESS & ASSOCIATES

Kirk D. Eschliman, P.L.S. Iowa Lic. No. 9961, 723 Broadway Street, Waterloo, Iowa 50703 - Phone: 319-234-0509


## UNITED STATES PUBLIC LAND SURVEY CORNER CERTIFICATE OF

LAND SURVEY MONUMENTS SITUATED IN SECTION 07, TOWNSHIP 88 NORTH  
 RANGE 14 WEST, OF THE FIFTH PRINCIPAL MERIDIAN, BLACK HAWK COUNTY, IOWA.  
 PREVIOUSLY RECORDED IN (NOT PREVIOUSLY RECORDED) (BOOK, PAGE, DOCUMENT NUMBER, ETC.) IN THE COUNTY RECORDER'S OFFICE.

(SHOW REASON FOR PREPARING THIS CERTIFICATE, THE EVIDENCE AND DETAILED PROCEDURES USED IN ESTABLISHING THE CORNER POSITIONS AND MONUMENTATION FOUND OR PLACED.)

MONUMENT DESCRIPTION AND REMARKS: FOUND 1" CLIP PIPE, 2" DEEP BELOW SURFACE  
Fee Bk. 2003-28883 (at) ALL MEASUREMENTS WERE TAKEN TO FACE OF OBJECTS

### PLAN - VIEW

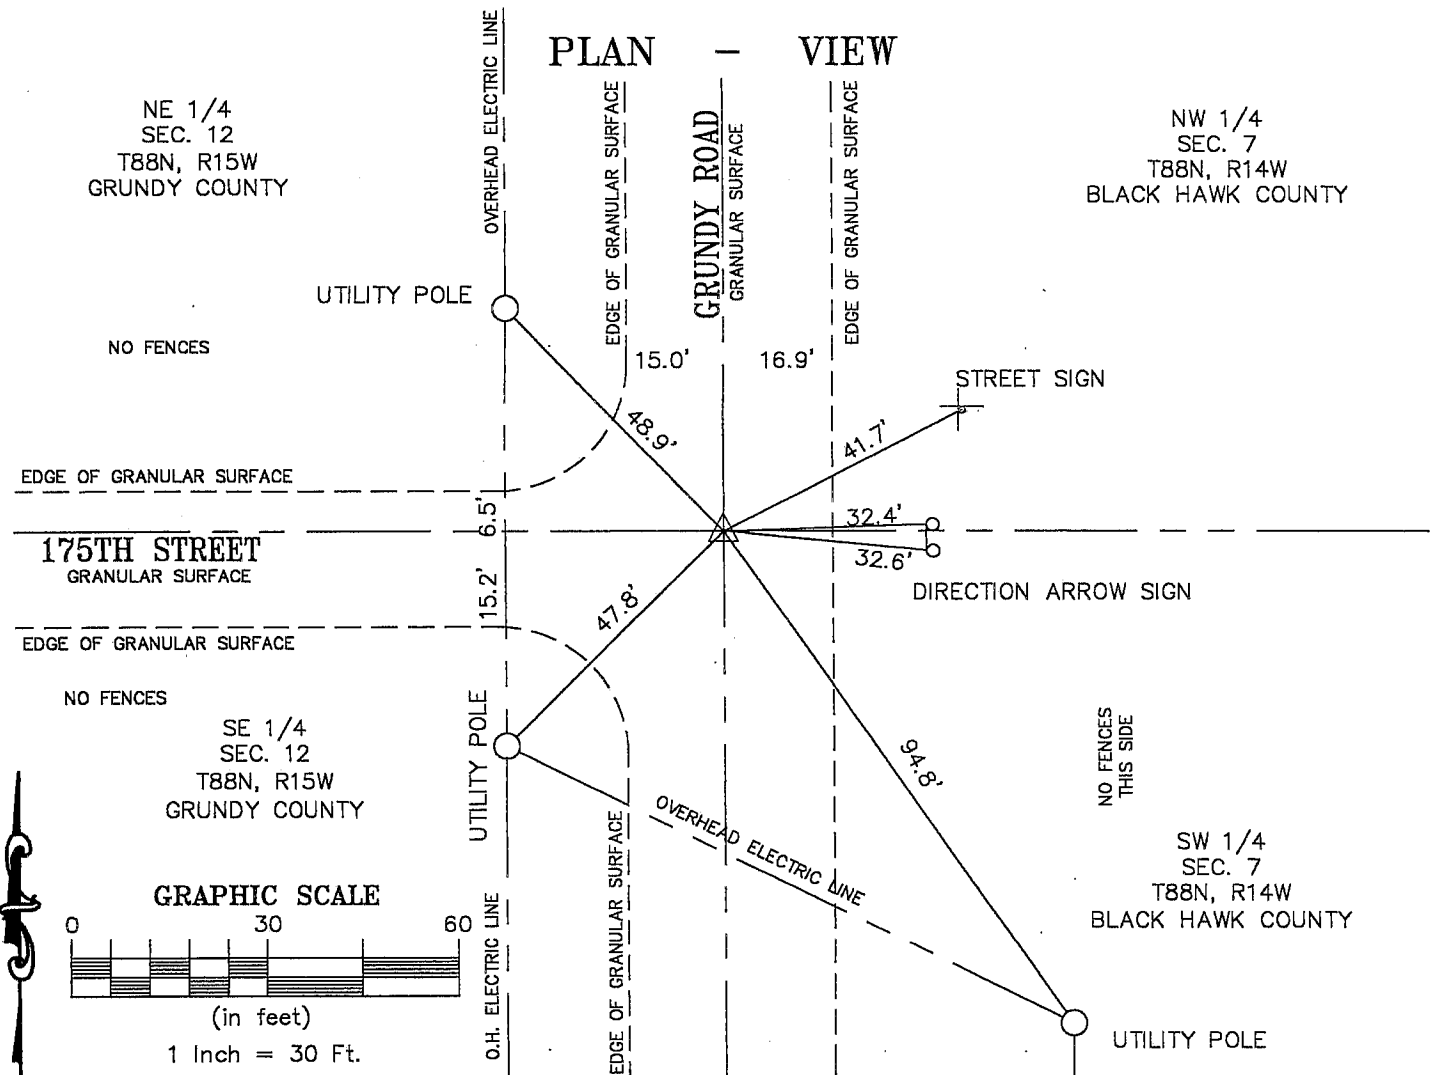

I HEREBY CERTIFY THAT THIS LAND SURVEYING DOCUMENT WAS PREPARED AND RELATED SURVEY WORK WAS PERFORMED BY ME OR UNDER MY DIRECT PERSONAL SUPERVISION AND THAT I AM A DULY LICENSED LAND SURVEYOR UNDER THE LAWS OF THE STATE OF IOWA.

*Kirk D. Eschliman*

DATE: 07/07/2004

KIRK D. ESCHLIMAN, P.L.S. IOWA LIC. NO. 9961  
 MY LICENSE RENEWAL DATE IS DECEMBER 31, 2005  
 PAGES OR SHEETS COVERED BY THIS SIGNATURE & SEAL: SHEET 1 OF 1

FOR: ROGER O GUTKNECHT TRUST  
 4635 GRUNDY ROAD  
 CEDAR FALLS

REQ. BY: ROGER GUTKNECHT  
 CEDAR FALLS




**KESS & ASSOCIATES, INC.**  
 PROFESSIONAL LAND SURVEYORS : 723 BROADWAY, WATERLOO, IOWA 50703-5811  
 DATE: 07/06/2004 C.A.D.D. FILE: 04B13CC0.DWG PROJECT NO.: 04B13

#### List of corners to be indexed:

| Corners | Section | Township | Range |
|---------|---------|----------|-------|
| W 1/4   | 07      | T88N     | R14W  |

#### SECTION 07

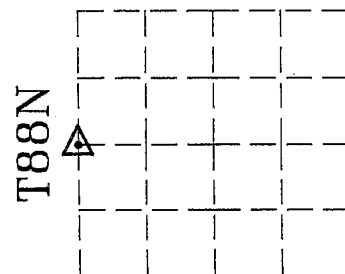

R14W